

WV STATE DEPARTMENT OF HEALTH
Office of Environmental Health Services
ENVIRONMENTAL ENGINEERING DIVISION

SW258

WELL COMPLETION REPORT

May 19, 1989 County Hampshire Permit #: DW-14-05-89-304
Points Area Name/Location Big Oak Estates lot #9
 Owner: HARRY JENKINS Address: RT #1, Box 74
 Telephone Number: (304) 725-7597 Summit Point, WV 25446
 Well Driller: JERRY W Adams Address: P.O. Box 73
 Telephone Number: 298-3280 Fort Ashby, WV 26719

WELL LOG

DEPTH IN FEET	FORMATIONS: KIND, THICKNESS, AND IF WATER BEARING	REMARKS:
0-11'	Clay & Shale UNCONSOLIDATED	Type of Well: <u>D/W</u>
12'	Brown Shale UNCONSOLIDATED	Well Diameter: <u>6"</u>
28'	Gray Shale UNCONSOLIDATED	Drilling Method: <u>Air Rotary Hammer</u>
39'	Limestone CONSOLIDATED	Casing O.D.: <u>6-5/8"</u>
50'	Limestone CONSOLIDATED	Well Depth: <u>200</u>
	Cement Set Casing	Date Completed: <u>MAY 19, 1989</u>
76'	Red Flintrock CONSOLIDATED	CASING: Length <u>51</u> Feet
95'	Limestone - Water 2 GPM	Height above ground <u>1</u> Feet
117'	Gray Shale CONSOLIDATED	<input checked="" type="checkbox"/> Steel <u>GALV.</u> <input type="checkbox"/> Plastic <input type="checkbox"/> Cast Iron
174'	Limestone CONSOLIDATED	Other _____ Type _____
187'	Limestone - Water 28 GPM	SCREEN
200'	Limestone CONSOLIDATED	<input checked="" type="checkbox"/> None Installed
	Stopped Drilling Operation	Type _____ Diameter _____
	Test Well Yield	Slot/Gauge _____ Length _____
		Set Between _____ Ft. and _____ Ft.

PUMPING OR BAILING TEST

DETAILS	#1	#2	#3
Static Water Level (Ft. Below Grade)	<u>34</u>		
Pumping Rate (GPM)	<u>30</u>		
Pumping Level (Ft. Below Grade)	<u>185</u>		
Duration of Test (In Hours)	<u>1</u>		
Recovery Time to Static Level (In Hours)	<u>2</u>		

WELL HEAD

Pitless Adapter: Type, Make, Etc. To be installed w/ Pump System
 Well Cap: Type, Make, Etc. Rayco 6-5/8" Conduit-Type
 Well Seal: Type, Make, Etc. _____
 Well Platform: To be installed by owner
 Length _____ Width _____ Thickness _____
 Grouting: ☐ Yes ☒ No
 All Public Water Supplies must be grouted.

I hereby certify that this well was drilled and constructed under my supervision, in compliance with all requirements of the referenced permit, and that this record is true to the best of my knowledge and belief.

JERRY W Adams
 Name
A & S Pump Co.
 Registered Business Name
Jerry W Adams
 Signed

004
 Certification No.

MAY 19, 1989
 Date

WEST VIRGINIA
SEPTIC TANK INSPECTION FORM

Impressions County Health Department Installation Permit No. ST-14-88-370
 Name of Owner Harry J. Jenkins
 Address Rt. 1, Box 74, Summit Point, WV 25446
 Property Address Big Oak Estates, lot #9 - Points

DESCRIPTION & NUMBER OF UNITS SERVED

Type Facility Served home No. Water Closets 1
 Lot Size 6 acres sq. ft. Area suitable for sewage disposal installation 1 sq. ft.
 Source of Water Supply well No. Lavatories 1
 No. Bedrooms 2 No. Showers or Tubs 1 No. Baths 1
 No. Garbage Grinders 1 No. Automatic Washers 1

SEPTIC TANK

Material pre-cast concrete Length 10' x Width 110' x Depth 100' = 11000 cubic feet
 Liquid Depth 1 ft. Liquid Capacity 1,000 gal.
 Distance to: Dwelling 10' Water Supply 110' Nearest Property Line 800'

SOIL ABSORPTION SYSTEM

Type Drain Line Material plastic Trench Width 36 Inches
 Trench Depth 20-24 Inches Total Absorption area in Trench Bottom 900 sq. ft.
 Diameter of Drain Line 4 Inches Type Filter Media #6 stone - 71-6
 No. of Drain Lines 3 Depth Filter Media Under Drain Line 12 Inches
 Length of Each Line 100, 100, 100, ft. Depth Filter Media Over Drain Line 2 in.
 Distance of Disposal Field to: (a) Dwelling 25'
 (b) Water Supply 125' (c) Nearest Property Line 800'

An inspection of the septic tank system described herein disclosed that said system (MEETS, DOES NOT MEET) the minimum standards established by the West Virginia State Department of Health.



7-26-89
Date

[Signature]
Sanitarian

SKETCH OF SYSTEM TO BE DRAWN ON BACK

Note: Copy of this inspection report must be given to owner and the original filed in the Health Department files. PERMANENT RECORD - DO NOT DESTROY.

Big Oak Estates Points W.V.

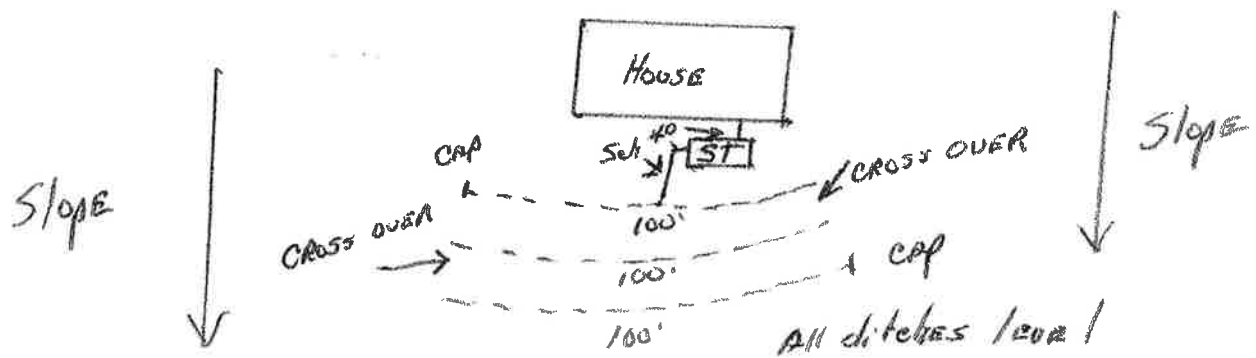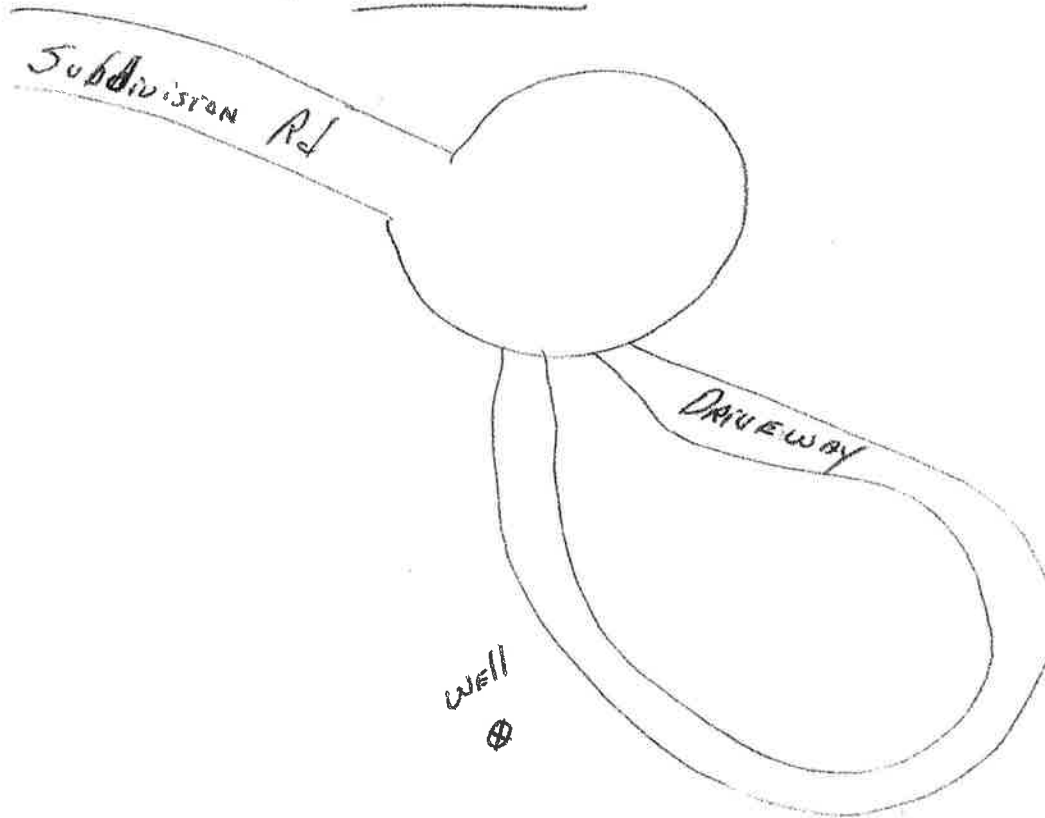

/// M M M M M M M M
/// M M M M M M M M
M M M M M M M M
TREES

Small stream