


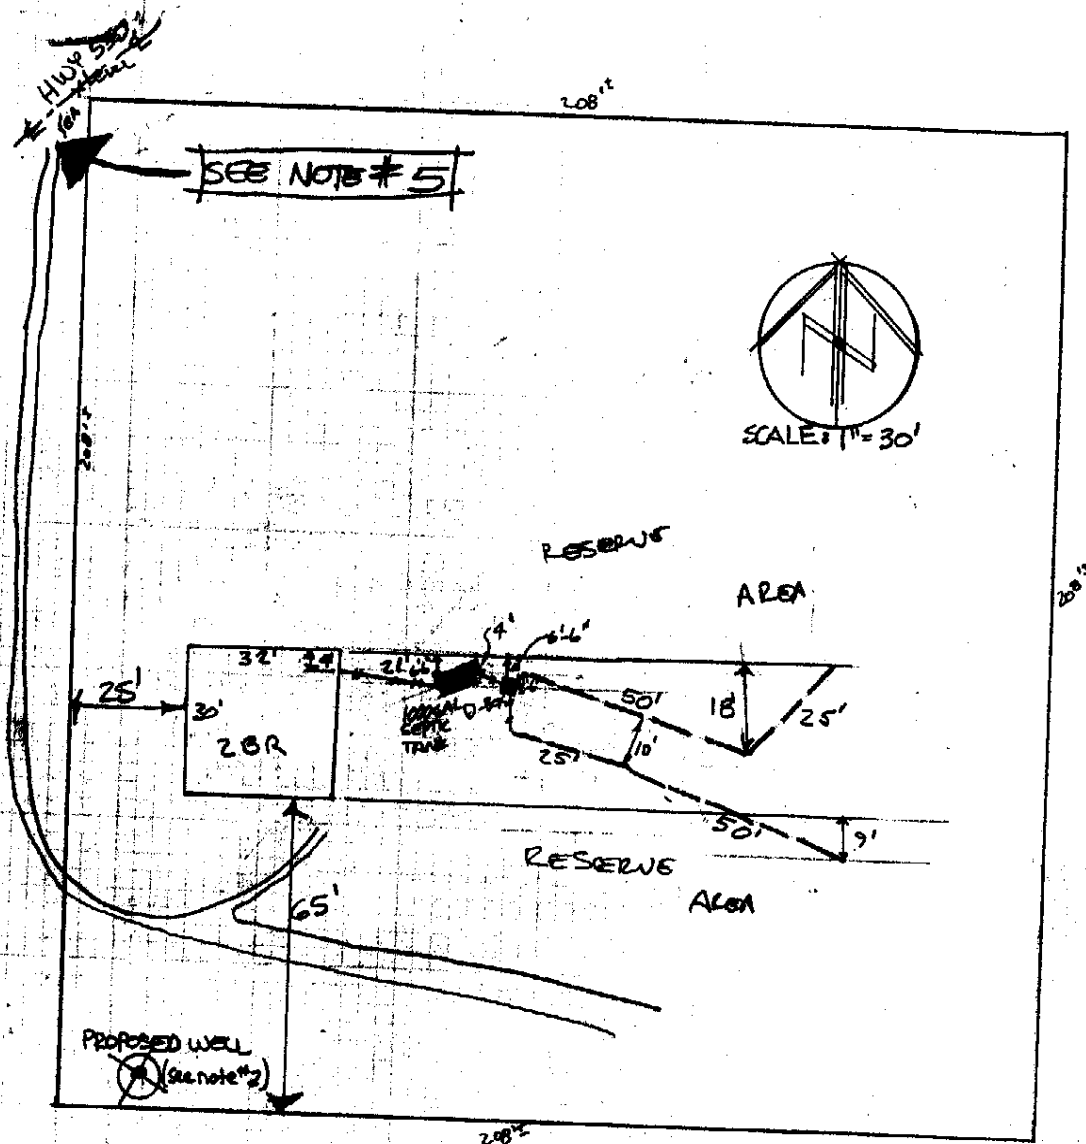

NOTES:

1. 300SF (1 SOL) OF TRENCH INSTALLED
2. WELL SHALL BE A MINIMUM 100' FROM DRAINFIELD AND RESERVE AREA (NOT ON SITE AT DATE OF INSPECTION)
3. HOMEOWNER INSTALLATION - JOHN STRICKLAND 1063 1/2 MAIN ST. #343 BELLEVUE 98004 (BB2-0371)
4. PTN OF S 1/2, SE 1/4, SW 1/4 AND E 1/2, N 1/2, SE 1/4 OF SW 1/4: 15-32-6
N 1/2, NE 1/4, NW 1/4 22-32-6
5. HOUSE SITE IS APPROXIMATELY 1 mile AND 1000 FEET FROM AND ABOVE DRIVEWAY ACCESS OFF HWY 530.
6. SEE SHEET 1 OF 2 FOR LOCATION

SHEET 2 OF 2

AS BUILT (INSPECTED 4/23/86)

JOHN STRICKLAND

ACT# 223206-2-001-0005

4 JUN 86 (RAB)

84-132