

WILLIAMSON COUNTY HEALTH DEPARTMENT
LICENSE TO OPERATE A PRIVATE SEWAGE FACILITY

THIS IS TO CERTIFY that the private sewage facility located at:

Nº 3580

RAYMOND & ALICE LYKINS

LIVE OAK PARK SEC. #2

LOT #5


meets or exceeds the basic requirements established by this department.

LICENSE TO OPERATE this facility is hereby granted to the owner. This license simply grants permission to operate this facility; it does not guarantee its successful operation. Routine maintenance and proper functioning are the sole responsibility of the owner.

KEEP THIS LICENSE with other house papers. You may need it when selling your house or if a malfunction occurs.

THIS LICENSE REMAINS in effect until such time as there is evidence that this facility is not operating properly and may constitute a threat to the health of the people of Williamson County.

DRAWING OF SYSTEM (not to scale):

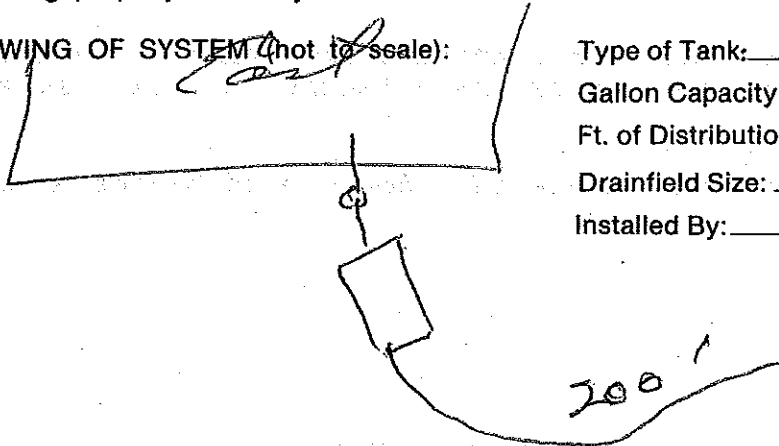

Type of Tank: Fiberglass
Gallon Capacity: 1000
Ft. of Distribution Pipe: 200
Drainfield Size: 4000 sq ft
Installed By: Self

DATE OF
FINAL INSPECTION:

March 18 1983

Issued this date 3-29-83

Edward J. Gardner
INSPECTOR

Tom Treer
CHIEF SANITARIAN