

\$W258

B. Mark Smith #001
Name B.W. Smith Well Drilling Certification No.
Registered Business Name
Signed Benjamin Mark Smith 5/6/00 Date

SS 177 7/86

INSPECTION TO BE
PRINTED OR TYPED

STATE OF WEST VIRGINIA
HEALTH DEPARTMENT
ON-SITE SEWAGE DISPOSAL SYSTEM
INSPECTION FORM

Permit No.: ST-14-08-344

Tax Map: _____ Parcel #: _____

County Road: _____

County: Wampscott

Name of Owner: William & Martha McDaniel Installer: W. Meade
Address: P.O. Box 41 Cupon Rd Edgemoor WV
Property Location: Dan and Red Ridge Subdivision Lot #47
Type of Facility: House Facility is: New ☒ Existing () Lot Size: 2.75 Acres
Design Loading in gpd/No. Bedrooms: 4 BR Source of Water Supply: well

SEWAGE TANK COMPONENT

Capacity in Gallons: 1000 Material: concrete Manufacturer: Jot
Distances (in feet) of Tank to: Dwelling: 58 Private (☒) Public () Water Source: 128 Property Line: 60

ON-SITE DISPOSAL SYSTEM

Class I Systems: Standard Soil Absorption Trenches () or Bed () Gravelless Pipe (1, Diameter: 10 inches
Chamber Soil Absorption Trenches () or Bed ()
Class II Systems: Pumped/Dosed Soil Absorption Trenches () or Bed () Evapotranspiration Trenches () or Bed ()
Shallow Soil Absorption Trenches () or Bed () Other: _____


No. of Lines: 4 Length (in feet) of Each: 100, 100, 100, 100
Width of Trenches: 24 inches/foot Depth to Bottom of Field: 24 inches
If Bed, Dimensions (in Feet): _____ If Chamber System, Name: _____, No. of Units: _____
Approved and Adequate Materials Used? Yes (☒) No () Size Equates to: _____ Square Feet of Standard Gravel Field.
Distances (in feet) of System to: Dwelling: 15 Private (☒) Public () Water Source: 100 Property Line: 40
Remarks: _____

An inspection indicates that the sewage disposal system described above
DOES MEET (☒),
DOES NOT MEET () ,
CANNOT BE DETERMINED TO MEET () the minimum standards established by the West Virginia Bureau of Public Health.

To correct a health hazard, modifications to existing systems may be done to improve part of a system. Such modifications may not be able to be designated as a does meet system since inadequate information is known.

Although many factors contribute to the successful functioning of a sewage disposal system, this office recommends water conservation and maintaining an even usage of water throughout the week.

Sketch of installation with Triangulation or Distance to Specific Landmarks:

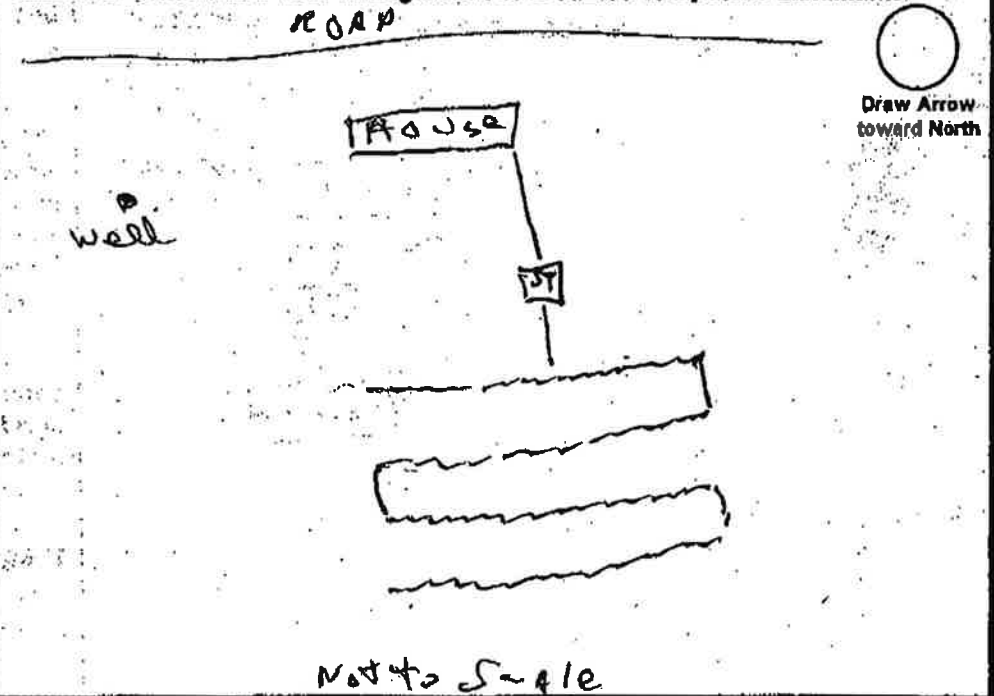

Visit Date(s): 8-2-00
Final Inspection Date: 6-12-00

Sanitarian: [Signature]

7/95

PERMIT TO BE
PRINTED OR TYPEDSTATE OF WEST VIRGINIA
Hampshire County HEALTH DEPARTMENT
ON-SITE SEWAGE DISPOSAL SYSTEM PERMIT

Permit No.: ST-14-00-311

Tax Map _____ Parcel # _____

County Road No.: _____

Owner: William & Martha Monclay
Address: PO Box 51
Cogan Bridge, WV 26031Certified Installer: Wendell Monclay
Address: Box 188
Cogan WV 26031You are hereby issued a permit to: ☒ install, or ☐ modify an on-site sewage disposal system located:Pummore Ridge Rd Pummore Ridge Subdivision
Deed Book 326 page 773Facility: None Design Flow: 4 BR Lot Size: 2.75 Acres Water Source: wellBASED UPON REVIEW OF THE INFORMATION OF YOUR SUBMITTED APPLICATION, DATED 3-28-00, AND THE PROPER INSTALLATION OF THE HEREIN DESCRIBED SYSTEM, THE SYSTEM SHALL BE IN COMPLIANCE WITH APPLICABLE WEST VIRGINIA SEWAGE SYSTEM RULES AND DESIGN STANDARDS.

The sewage system shall consist of a:

- ☒ Septic tank - Capacity: 1000 gallons or more, Constructed of: concrete
- ☒ Soil disposal system with a minimum equivalency of 1200 square feet of conventional gravel trench area.
Depth to the bottom of the trench or bed installation shall be: 24-36 inches from original ground surface.
- ☐ Gravel system: Lengths of lines: 100, 100, 100, 100 feet, Width: 36 inches
- ☐ Chamber system: Number of units: _____, Length of lines: _____, _____, _____ units,
Manufacturer of chamber: _____
- ☐ Bed system: ☐ Gravel, ☐ Chamber, Length: _____ feet, Width: _____ feet.
- ☐ Other: ☒ May also be 10" gravelless or equivalent 36" chamber system,
Diversion Ditch if needed

This permit is non-transferable and automatically expires 12 months after issue date.


This permit is **NULL and VOID** when official inspection reveals conditions different than those stipulated on the permit or facts are later found that would indicate non-compliance with applicable rules.

All systems must be inspected and approved prior to being covered with earth or placed into use.

The applicant or his agent must notify this department: 72 hours or more prior to planned inspection time.

Sketch of system:

NOT TO SCALE

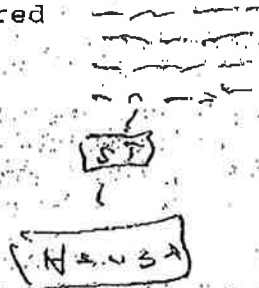10,000
Square foot
Reserve
Area
RequiredDraw Arrow
Toward North

well

Issue Date 6-7-00Additional specifications
on reverse:

Health Officer or Sanitary