

WV STATE DEPARTMENT OF HEALTH
Office of Environmental Health Services
ENVIRONMENTAL ENGINEERING DIVISION

SW258

WELL COMPLETION REPORT

Date(s) 10-15-92 10-15-93 County Hampshire Permit #: DW-14-10-93-122
Town: PIN OAK Area Name/Location The Crossings Lt # 87
Well Owner: Scott Staubs Address: 3333 University Blvd. W. 502
Telephone Number: 301 946 1220 Kensington Md. 20895
Well Driller: Paul HOFE Address: RR6 Box 214
Telephone Number: 754 3961 Mtbg. W. V. 25401

WELL LOG

DEPTH IN FEET	FORMATIONS: KIND, THICKNESS, AND IF WATER BEARING	REMARKS:
0 - 23	soft gray shale	Type of Well: <u>Residential</u> Drilling Method: <u>Air Perc</u>
23 - 25	yellow shale	Well Diameter: <u>6 1/8</u> Casing O.D.: <u>6 5/8</u>
25 - 620	Hard gray shale	Well Depth: <u>620</u> Date Completed: <u>11-2-92</u>
		CASING: Length <u>42</u> Feet Height above ground <u>1</u> Feet
		<input checked="" type="checkbox"/> Steel <input type="checkbox"/> Plastic <input type="checkbox"/> Cast Iron
		Other _____ Type _____
		SCREEN
		<input checked="" type="checkbox"/> None Installed
		Type _____ Diameter _____
		Slot/Gauge _____ Length _____
		Set Between _____ Ft. and _____ Ft.

PUMPING OR BAILING TEST

DETAILS	#1	#2	#3
Static Water Level (Ft. Below Grade)	180		
Pumping Rate (GPM)	40		
Pumping Level (Ft Below Grade)	600		
Duration of Test (In Hours)	.5		
Recovery Time to Static Level (In Hours)	.25		

WELL HEAD

Pitless Adapter: Type, Make, Etc. N/A
Well Cap: Type, Make, Etc. Royer w/conduit
Well Seal: Type, Make, Etc. N/A
Well Platform:
Length _____ Width _____ Thickness _____
Grouting: ☐ Yes ☒ No
All Public Water Supplies must be grouted.

I hereby certify that this well was drilled and constructed under my supervision, in compliance with all requirements of the referenced permit, and that this record is true to the best of my knowledge and belief.

Name Paul HOFE Certification No. 017
Registered Business Name HOFES WELL DRIG.
Signed Paul J. HOFE Date 12-11-92

WEST VIRGINIA
SEPTIC TANK INSPECTION FORM

Homestead County Health Department Installation Permit No. ST-14-91-385

Name of Owner Scott Staubs

Address 3333 University Blvd. Apt. W-502, Kensington, MD

Property Address Crossing Lot #87 20885

DESCRIPTION & NUMBER OF UNITS SERVED

Type Facility Served house No. Water Closets

Lot Size 5+ acres sq. ft. Area suitable for sewage disposal installation sq. ft.

Source of Water Supply well No. Lavatories

No. Bedrooms 2 No. Showers or Tubs No. Baths

No. Garbage Grinders No. Automatic Washers

SEPTIC TANK

Material concrete Length x Width x Depth = cubic feet

Liquid Depth ft. Liquid Capacity 1100 gal.

Distance to: Dwelling 34'6" Water Supply 115' Nearest Property Line 40'

SOIL ABSORPTION SYSTEM

Type Drain Line Material gravelless Trench Width 20 Inches

Trench Depth 20 Inches Total Absorption area in Trench Bottom 600 sq. ft.

Diameter of Drain Line 10 Inches Type Filter Media

No. of Drain Lines 3 Depth Filter Media Under Drain Line Inches

Length of Each Line 70, 100, 30, ft. Depth Filter Media Over Drain Line in.

Distance of Disposal Field to: (a) Dwelling 57'

(b) Water Supply 151' (c) Nearest Property Line 10'

An inspection of the septic tank system described herein disclosed that said system (MEETS, DOES NOT MEET) the minimum standards established by the West Virginia State Department of Health.

11-12-92
Date

Lee Hana
Sanitarian


SKETCH OF SYSTEM TO BE DRAWN ON BACK

Note: Copy of this inspection report must be given to owner and the original filed in the Health Department files. PERMANENT RECORD - DO NOT DESTROY.

11/10

River

ARC

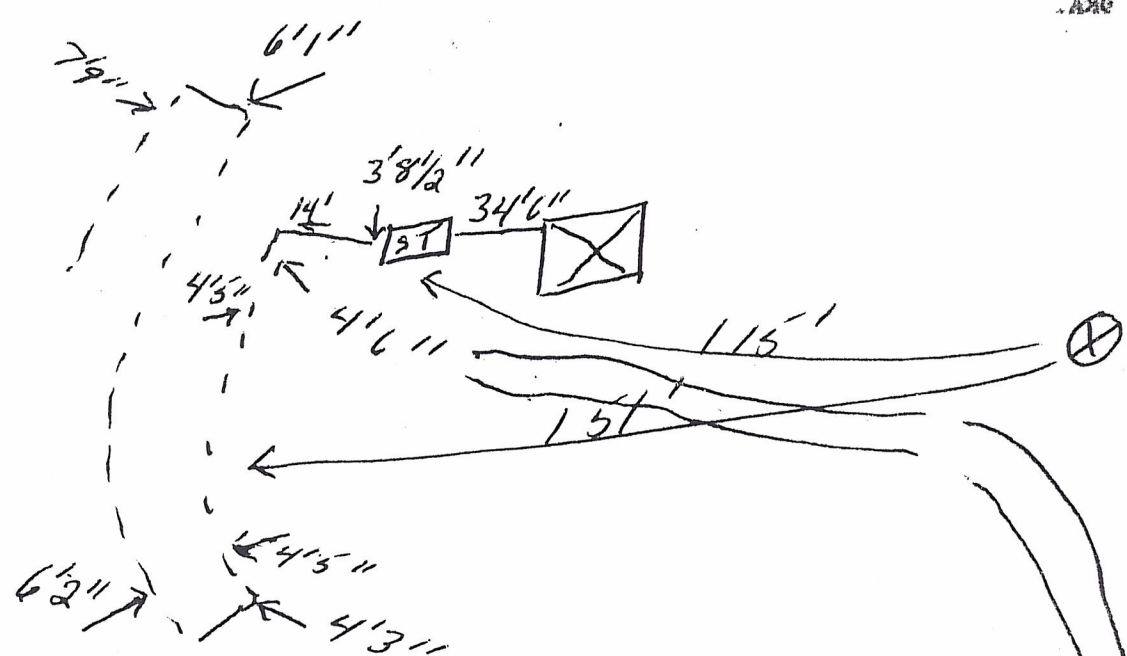

S/D Road