



Lat: N: 39.109 320

Hardy County Department of Health

Tax Map Name: _____

Long: W 78 882 815

**ON-SITE SEWAGE DISPOSAL SYSTEM
INSPECTION REPORT**

Map # _____ Parcel # _____

Name of Owner: Stephan & Susan Shelton Installer: Eugene Rinker

Owner Address: 11303 HAZEL RIVER ROAD Rixeyville, VA 22737

Property Location: ASHTON WOODS SUBDIVISION LOT 12 CLIFFORD HOLLOW ROAD

Subdivision: ASHTON WOODS Lot number: 12

Type of Facility: NEW HOME Facility is: New ☒ Existing ☐ Lot Size (ft²/acres): 20.89

Design Loading: Bedrooms: 3 or GPD: _____ Water Supply: Existing ☐ Proposed ☒ Type: WELL

System requires a perpetual maintenance program as per 64CSR9.7.2: Yes ☐ No ☒

SEWAGE TANK COMPONENTS

SEPTIC TANK	Septic Tank 1:	Septic Tank 2:	Pump Chamber:	SEPTIC TANK	Septic Tank 1:	Septic Tank 2:	Pump Chamber:
Capacity in Gallons:	<u>1000</u>			Distance to dwelling:	<u>NOT CONSTRUCTED AT TIME OF INSPECTION</u>		
Constructed of:	<u>Concrete</u>			Distance to water			
Manufacturer:	<u>JOHN</u>			Line:			
4" inspection port, or riser to surface?	Riser ☒ Port ☐	Riser ☐ Port ☐	Riser ☐	Source:	<u>50'</u>		
				Distance to property line:	<u>100'</u>		
				Effluent filter?	Yes ☐ No ☒	Yes ☐ No ☐	

ABSORPTION FIELD

Class I System: Chamber: ☒ Eljen ☐ Gravelless Pipe: ☐ Gravel Media Trenches ☐ Other: _____

Manufacturer: INFILTRATOR Square footage: Permitted 1200 ft² Installed 1200 ft²

Number of lines: 3 Trench width: 18-36 inches

Lengths of lines: 80, 80, 80, , , , , , , , , ,

Inspection ports installed? Yes ☐ No ☒ Distribution box used? Yes ☒ No ☐ Outlets level? Yes ☒ No ☐

If chambers, length of each section: 4' Gravelless pipe diameter: _____

If bed configuration used, dimensions: _____ X _____ Maximum depth to bed bottom on upslope side: _____

Distance of absorption field to: Dwelling: _____, Water Supply: 100', Water Line: _____, Property Line: 100'

Drainfield laterals installed on-contour: Yes ☒ No ☐ Average Depth: 24" Maximum depth: 36"

Class II System: Design type: _____


Remarks: HOME WAS NOT ON LOCATION AT TIME OF SEPTIC INSTALL

System is installed as per the permitted design and layout. Yes ☒ No ☐
Include sketch of installation on reverse.

**Sketch of Installation with Triangulation or Distance to Specific Landmarks.
Include reserve area boundaries.**

LEGEND:

	House/Facility		Property Line		Fence		Pump Tank
	Soil Absorption Line		Single Wide Manufactured Home		North		Septic Tank
	Existing Water Supply		Distribution Box		Stream Flow		
	Proposed Water Supply		Drain Field Inspection Port		Wooded Area Boundary		

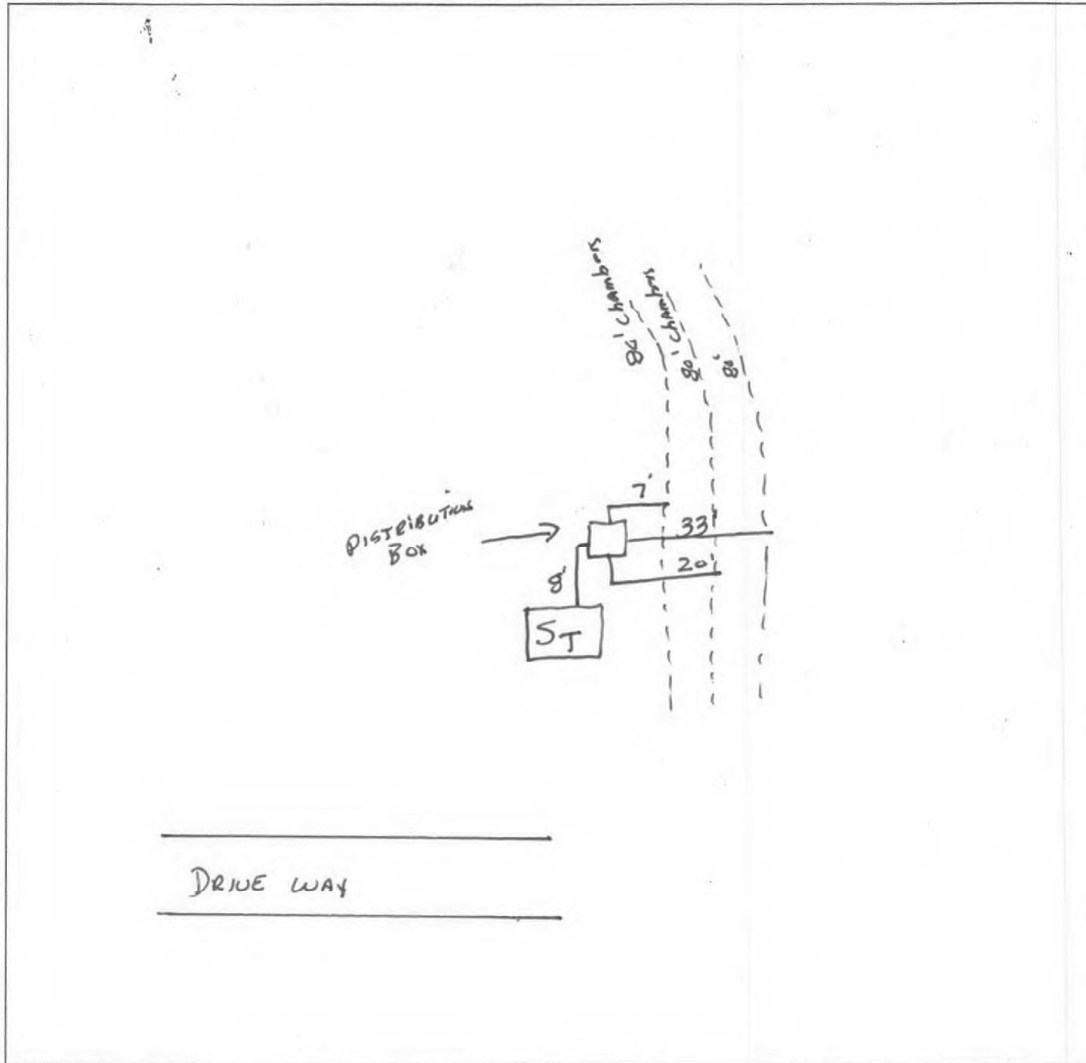

System is: Approved ☒ System is NOT Approved: ☐

COMMENTS:

Dates visited:

Will Omy
Sanitarian

4-1-2020
Date Final Inspection