

SS 177 7/96

## STATE OF WEST VIRGINIA

INSPECTION TO BE  
PRINTED OR TYPED

HEALTH DEPARTMENT

Permit No.: ST-1400-390

Tax Map: 196 Parcel #: 18

County: WAMPSHIREON-SITE SEWAGE DISPOSAL SYSTEM  
INSPECTION FORM

County Road: \_\_\_\_\_

Name of Owner: CHARLES Mello & Mello Installer: Duffy, DionsAddress: RT 2 Box 245 Kearneyville, WV 25430Property Location: Hill Mt ORCHARD RD #4Type of Facility: W-180 Facility is: New (X) Existing ( ) Lot Size: 4 Sq. Ft./AcresDesign Loading in gpd/No. Bedrooms: 3 BR Source of Water Supply: CISTERN

## SEWAGE TANK COMPONENT

Capacity in Gallons: 1000 Material: Concrete Manufacturer: JG (w)Distances (in feet) of Tank to: Dwelling: 104 Private ( )/Public ( ) Water Source: 50' Property Line: 104

to be

## ON-SITE DISPOSAL SYSTEM

to be

Class I Systems: Standard Soil Absorption Trenches ( ) or Bed ( ) Gravelless Pipe (X), Diameter: 10 Inches  
 Chamber Soil Absorption Trenches ( ) or Bed ( )  
 Class II Systems: Pumped/Dosed Soil Absorption Trenches ( ) or Bed ( ) Evapotranspiration Trenches ( ) or Bed ( )  
 Shallow Soil Absorption Trenches ( ) or Bed ( ) Other: \_\_\_\_\_

No. of Lines: 4 Length (in feet) of Each: 80, 100, 80, 40Width of Trenches: 24 inches/feet Depth to Bottom of Field: 24 inches

If Bed, Dimensions (in Feet): \_\_\_\_\_ If Chamber System, Name: \_\_\_\_\_, No. of Units: \_\_\_\_\_

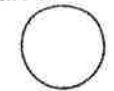
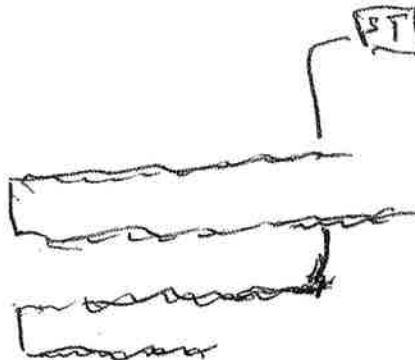
Approved and Adequate Materials Used? Yes (X) No ( ) Size Equates to: 900 Square Feet of Standard Gravel Field.Distances (in feet) of System to: Dwelling: 104 Private ( )/Public ( ) Water Source: 104' Property Line: 104Remarks: to be to be

An inspection indicates that the sewage disposal system described above  
**DOES MEET (X),**  
**DOES NOT MEET ( ),**  
**CANNOT BE DETERMINED TO MEET ( )** the minimum standards established by the West Virginia Bureau of Public Health.

To correct a health hazard, modifications to existing systems may be done to improve part of a system. Such modifications may not be able to be designated as a does meet system since inadequate information is known.

Although many factors contribute to the successful functioning of a sewage disposal system, this office recommends water conservation and maintaining an even usage of water throughout the week.

Sketch of Installation with Triangulation or Distance to Specific Landmarks:

NOT to SCALEDraw Arrow  
toward NorthVisit Date(s): 6-1-00Final Inspection Date: 4-19-02Sanitarian: J. Zunda

**The proposed sewage system shall consist of:**Septic Tank: Capacity: 1000 gallons Material: Concrete Manufacturer: Jo-LinAbsorption Field: Equivalent to 900 square feet of conventional gravel trench system.☒ Trench System: No. of Lines: 3, Lengths: 100, 100, 100, \_\_\_\_\_, \_\_\_\_\_, \_\_\_\_\_ feet.☐ Gravel Trench Width: \_\_\_\_\_ inches, or Gravelless Pipe Diameter: \_\_\_\_\_ inches,☐ If Chamber System: Manufacturer: \_\_\_\_\_, Number of Chambers: \_\_\_\_\_.☐ Soil absorption bed: Requires an oversizing of bottom surface area by 30%.

If soil absorption bed, Length: \_\_\_\_\_ feet by Width: \_\_\_\_\_ feet, or if Chamber System,

Manufacturer: \_\_\_\_\_, Number of Chambers: \_\_\_\_\_.

**Distances (to nearest):**Septic Tank to: Building Foundation: 20<sup>Prior Markings</sup> feet, Property Line: 200<sup>+</sup> feet, Water Supply: NA feet.Absorption Field to: Building Foundation: 50<sup>+</sup> feet, Property Line: 20<sup>+</sup> feet, Water Supply: NA feet.**Materials:**

The installation or modification of all parts of the sewage disposal system, including required material standards, shall be done in compliance with applicable design standards issued by the Public Health Sanitation Division, Office of Environmental Health Services, and appropriate manufacturer's recommended procedures and practices.

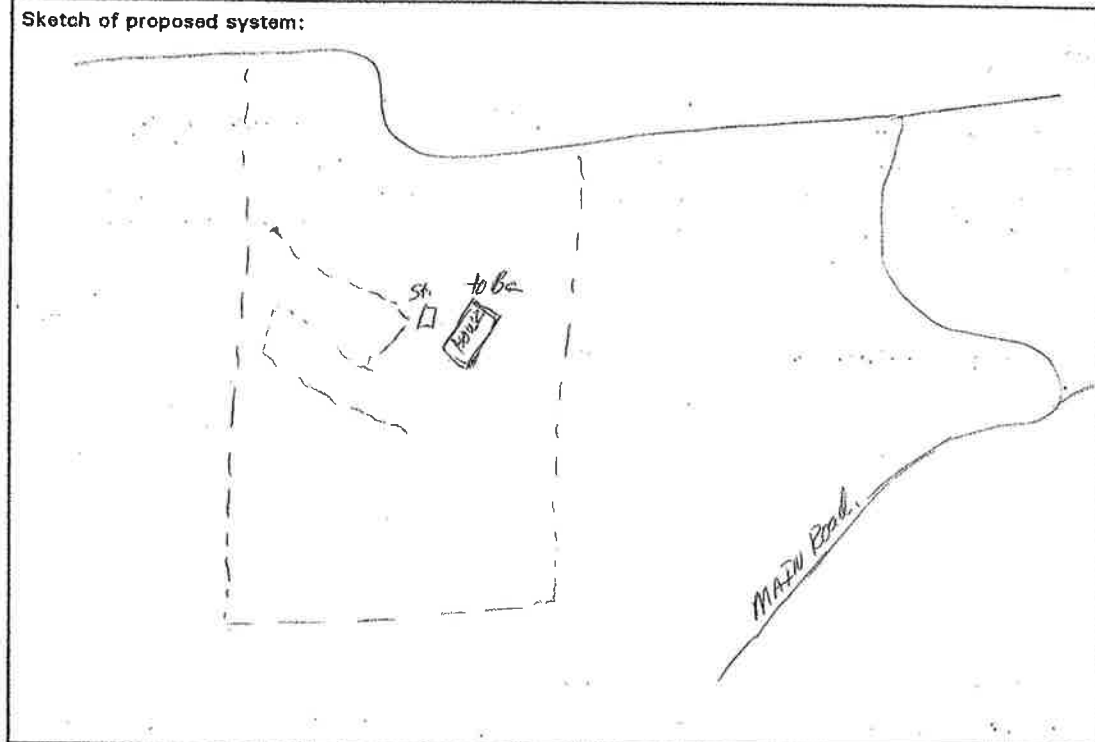
Signature of Certified Installer or Owner-Installer: Walter S. Stone

Draw a sketch of the property showing existing or proposed well locations that would be within 200 feet of the proposed on-site sewage system, location of structures, and property line locations.

- Direction of ground slope
- ⊙ Percolation test site
- Property line
- ⊗ Residence or facility served
- ST Septic Tank
- - Soil absorption lines
- |||| Trees
- ⊗ Water source
- \* Water supply line

Show all structures or facilities to be served by on-site sewage system on the lot or tract.

Sketch of proposed system:

**FOR HEALTH DEPARTMENT USE ONLY:**Date Received: 4-3-02

Date Site Evaluated: \_\_\_\_\_

Received From: \_\_\_\_\_

COUNTY: \_\_\_\_\_

Coordinates: N \_\_\_\_\_ W \_\_\_\_\_

Reviewed by: \_\_\_\_\_ Date fee paid: \_\_\_\_\_

Permit: ☐ Issued ☐ Denied Permit No.: \_\_\_\_\_