

WEST VIRGINIA
SEPTIC TANK INSPECTION FORM

Hampshire County Health Department Installation Permit No. ST-14-81-68

Name of Owner DEFAZIO, CARL

Address P.O. Box 473, Romney, W. VA.

Property Address KIRBY, 1/2 MI. WEST PASS SCHOOL, LEFT 1/2 MI. TO 2ND DRIVE W.

DESCRIPTION & NUMBER OF UNITS SERVED

Type Facility Served NEW HOUSE No. Water Closets 2

Lot Size 33 ACRES sq. ft. Area suitable for sewage disposal installation 15,000 sq. ft.

Source of Water Supply DRILLED WELL No. Lavatories 2

No. Bedrooms 3 No. Showers or Tubs 2 No. Baths 2 1/2

No. Garbage Grinders 0 No. Automatic Washers 1

SEPTIC TANK

Material CONCRETE Length _____ x Width _____ x Depth _____ = _____ cubic feet

Liquid Depth _____ ft. Liquid Capacity 1,000 gal.

Distance to: Dwelling 40' Water Supply 70' Nearest Property Line 100'

SOIL ABSORPTION SYSTEM

Type Drain Line Material PLASTIC Trench Width 36" x 24" Inches

Trench Depth 30 Inches Total Absorption area in Trench Bottom 600 sq. ft.

Diameter of Drain Line 4 Inches Type Filter Media GRAVEL

No. of Drain Lines 2 Depth Filter Media Under Drain Line 6 Inches

Length of Each Line 100', 100', _____ ft. Depth Filter Media Over Drain Line 2 in

Distance of Disposal Field to: (a) Dwelling 110'

(b) Water Supply 125' (c) Nearest Property Line 100'


An inspection of the septic tank system described herein disclosed that said system (MEETS, ~~DOES NOT MEET~~) the minimum standards established by the West Virginia State Department of Health.

DEC. 10, 1981
Date

Sanitarian

SKETCH OF SYSTEM TO BE DRAWN ON BACK

Note: Copy of this inspection report must be given to owner and the original filed in the Health Department files. PERMANENT RECORD - DO NOT DESTROY.

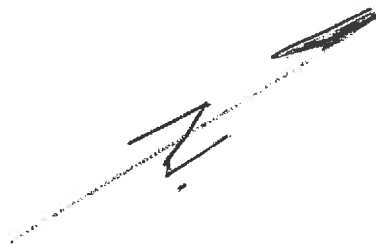

WEI
⊕

