

WEST VIRGINIA
SEPTIC TANK INSPECTION FORM

Hampshire County Health Department Installation Permit No. ST-14-91-604
Name of Owner Patten Corp.

Address _____

Property Address Crossings Lot #164

DESCRIPTION & NUMBER OF UNITS SERVED

Type Facility Served new home No. Water Closets _____
Lot Size 3.79 ^{acres} ~~sq. ft.~~ Area suitable for sewage disposal installation _____ sq.ft.
Source of Water Supply well No. Lavatories _____
No. Bedrooms 2 No. Showers or Tubs _____ No. Baths _____
No. Garbage Grinders _____ No. Automatic Washers _____

SEPTIC TANK

Material concrete Length _____ x Width _____ x Depth _____ = _____ cubic feet
Liquid Depth _____ ft. Liquid Capacity 1000 and 750 gal.
Distance to: Dwelling 15 Water Supply 100 Nearest Property Line 100

SOIL ABSORPTION SYSTEM

Type Drain Line Material gravelless Trench Width 24 Inches
Trench Depth 24 Inches Total Absorption area in Trench Bottom 600 sq. ft.
Diameter of Drain Line 10 Inches Type Filter Media _____
No. of Drain Lines 2 Depth Filter Media Under Drain Line _____ Inches
Length of Each Line 100, 100, , ft. Depth Filter Media Over Drain Line _____ in.
Distance of Disposal Field to: (a) Dwelling 100
(b) Water Supply 100 (c) Nearest Property Line 40

An inspection of the septic tank system described herein disclosed that said system (MEETS, DOES NOT MEET) the minimum standards established by the West Virginia State Department of Health.

Date

[Signature]
Sanitarian

SKETCH OF SYSTEM TO BE DRAWN ON BACK

Note: Copy of this inspection report must be given to owner and the original filed in the Health Department files. PERMANENT RECORD - DO NOT DESTROY.

WEST VIRGINIA
SEPTIC TANK SPECIFICATION FORM

HAMPSHIRE COUNTY HEALTH DEPARTMENT

INSTALLATION PERMIT NO. _____

NAME OF OWNER _____

ADDRESS _____

PROPERTY ADDRESS The Crossings Lot # 164

DESCRIPTION & NUMBER OF UNITS SERVED

TYPE FACILITY SERVED New Home LOT SIZE _____ ACRES/SQ.FT.

SOURCE OF WATER SUPPLY well NO. BEDROOMS 2

NO. GARBAGE GRINDERS _____ NO. AUTOMATIC WASHERS _____

SEPTIC TANK

MATERIAL Concrete LIQUID CAPACITY 1000 and 750 GALLONS

DISTANCE TO: DWELLING 1.5 WATER SUPPLY 100 NEAREST PROPERTY LINE 100

SOIL ABSORPTION SYSTEM

TYPE DRAIN LINE MATERIAL plastic DIAMETER OF DRAIN LINE 10 INCHES

TRENCH WIDTH 24 INCHES TRENCH DEPTH 24 INCHES

NO. OF DRAIN LINES 2 LENGTH OF EACH LINE 100, 100, _____, _____, _____, FT.

TOTAL ABSORPTION AREA IN TRENCH BOTTOM 600 SQ.FT.

TYPE FILTER MEDIA N/A TONAGE N/A

DEPTH FILTER MEDIA UNDER DRAIN LINE 1/2 INCHES

DEPTH FILTER MEDIA OVER DRAIN LINE 1/2 INCHES

DISTANCE OF DISPOSAL FIELD TO:

(A) DWELLING 100

(B) WATER SUPPLY 100

(C) NEAREST PROPERTY LINE 40

DATE

7-12-93


INSTALLER (SIGNATURE)

Steven C. Peasemaker

CERTIFICATION NUMBER

54-89-0214

SKETCH OF SYSTEM TO BE DRAWN ON BACK
(PLEASE NOTE TRANSIT READINGS)

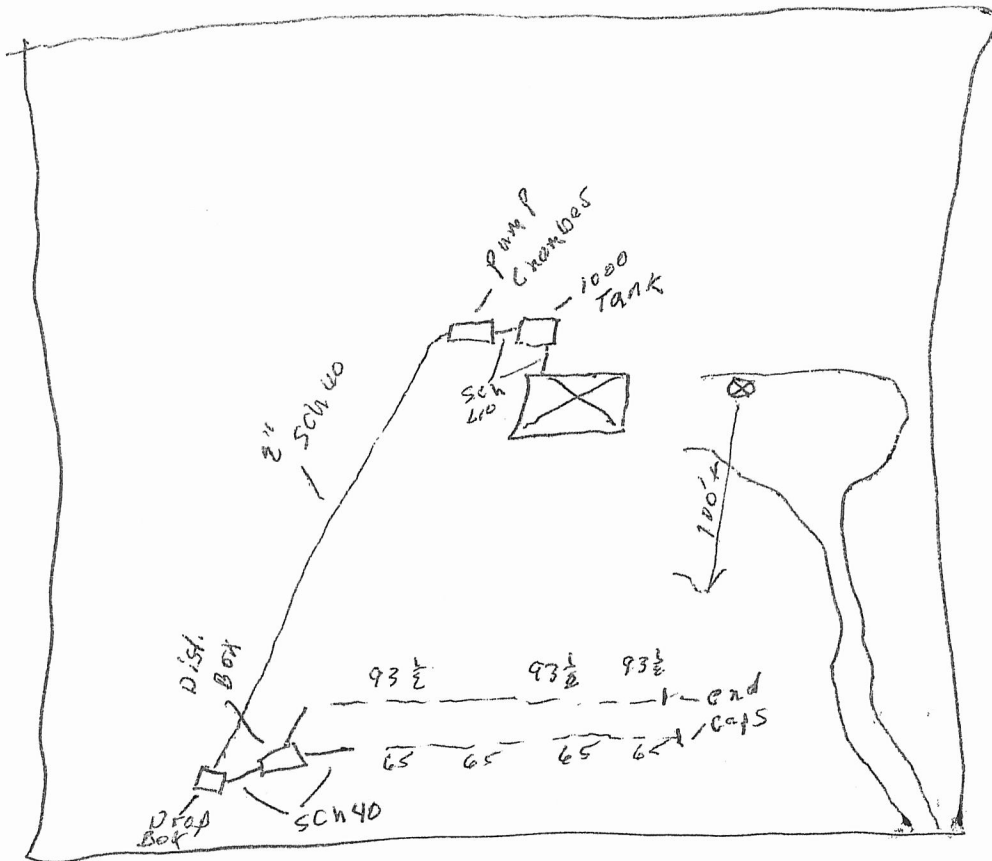

SP / RD

WV STATE DEPARTMENT OF HEALTH
Office of Environmental Health Services
ENVIRONMENTAL ENGINEERING DIVISION

SW258

WELL COMPLETION REPORT

Date(s) 2-4-93 2-4-94 County Hampshire Permit #: DW-14-02-93-191
Town: PIN OAK Area Name/Location Crossings Lot #164
Well Owner: J. Thomas Stocker Address: 6604 Landin Lane
Telephone Number: 301-229-0991 Bethesda Md. 20817
Well Driller: Paul HOFE Address: RR6 Box 214
Telephone Number: 754 3961 Mtbg. W.V. 25401

WELL LOG

DEPTH IN FEET	FORMATIONS: KIND, THICKNESS, AND IF WATER BEARING	REMARKS:
0 - 10	yellow shale	Type of Well: <u>Residential</u> Drilling Method: <u>Air Perc.</u>
10 - 35	Brown shale	Well Diameter: <u>6 1/8</u> Casing O.D.: <u>6 5/8</u>
35 - 42	Red shale	Well Depth: <u>320</u> Date Completed: <u>4-8-93</u>
42 - 52	Brown shale	CASING: Length <u>60</u> Feet Height above ground <u>1</u> Feet
52 - 320	Black shale	☒ Steel ☐ Plastic ☐ Cast Iron
		Other _____ Type _____
		SCREEN
		☒ None Installed
		Type _____ Diameter _____
		Slot/Gauge _____ Length _____
		Set Between _____ Ft. and _____ Ft.

PUMPING OR BAILING TEST

DETAILS	#1	#2	#3
Static Water Level (Ft. Below Grade)	<u>50</u>		
Pumping Rate (GPM)	<u>4</u>		
Pumping Level (Ft Below Grade)	<u>310</u>		
Duration of Test (In Hours)	<u>.5</u>		
Recovery Time to Static Level (In Hours)	<u>1.5</u>		

WELL HEAD


Pitless Adapter: Type, Make, Etc. N/A
Well Cap: Type, Make, Etc. Royer w/conduit
Well Seal: Type, Make, Etc. N/A
Well Platform:
Length _____ Width _____ Thickness _____
Grouting: ☐ Yes ☒ No
All Public Water Supplies must be grouted.

I hereby certify that this well was drilled and constructed under my supervision, in compliance with all requirements of the referenced permit, and that this record is true to the best of my knowledge and belief.

Paul HOFE 017
Name Certification No.
HOFE'S WELL Drlg.
Registered Business Name
Paul J. Hafe 4-14-93
Signed Date

Please draw a sketch of the property showing existing or proposed well location, location of structures, existing or proposed sewage systems, within 200 feet of well location, slope of site and lot dimensions. Locate animal pens, barnyards or any other factors which can be a possible source of contamination for the water supply.

	House		Water Supply		Percolation Test Site
	Soil Absorption Line		Dir. of Ground Slope		Property Line
	Trees		Septic Tank		Mobilehome

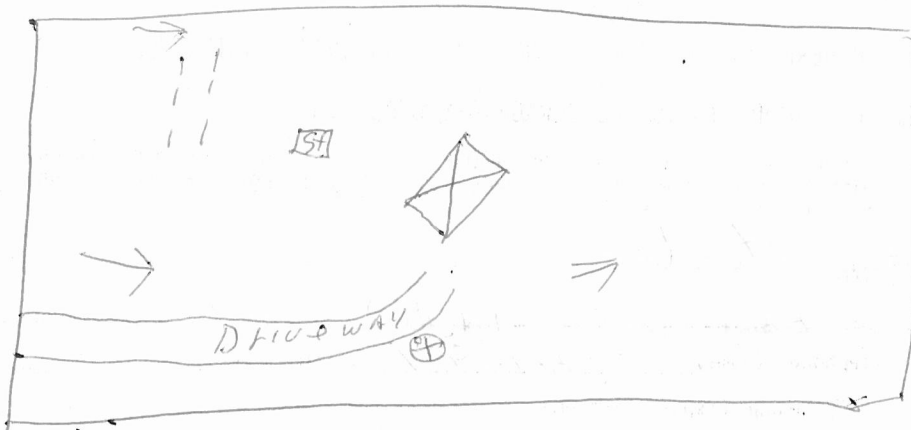

LOTS 2 ACRES & UNDER; ATTACH COPY OF PLAT WITH DESIGNATED 10,000 SQUARE FOOT SEPTIC AREA MARKED BY SURVEYOR

PART III SEWAGE DISPOSAL SYSTEM INFORMATION

☐ Install ☐ Modify

☐ Septic Tank ☐ Absorption Field ☐ Holding Tank ☐ Pit Privy ☐ Vault Privy

☐ Chemical/Composting Toilet ☐ Alternate System (attach detailed plans)

Other _____

DESCRIPTION OF PROPOSED SYSTEM:

Septic Tank: Capacity _____ Material _____ Nearest Prop. Line _____

Absorption Field: _____ Sq. ft. with _____ lines and _____ long

Pipe ASTM No. _____ Nearest Property Line _____

Type of Water Supply: _____ Area Suitable for Absorption Field: _____ Sq. ft.

Six-foot hole free of water or solid rock? ☐ Yes ☐ No

PERCOLATION TEST:

TEST HOLE: #1 #2 #3 #4

 minutes minutes minutes minutes

Total minutes _____, divided by 24 = _____ average time for water to fall one inch.

Test done on _____ (date) using approved procedures outlined in the Design Standards.

Signed: _____

Signature of Installer _____

Certification No. _____ Date _____

INSTALLER'S ADDRESS: _____

SEPTIC SYSTEM PERMIT RECEIPT NO. _____
DATE RECEIVED _____
RECEIVED FROM _____