

WEST VIRGINIA
SEPTIC TANK INSPECTION FORM

Hampshire Health Department Installation Permit No. ST 148472
Name of Owner Eugene M. Crouse (EUGENE M. CROUSE)
Address 1508 Northcrest Dr. Silver Spring, Md 20904
Property Address Falcon Woods #15 (Pin Oak Area)

DESCRIPTION & NUMBER OF UNITS SERVED

Type Facility Served Cabin No. Water Closets _____
Lot Size 2+ acres sq. ft. Area suitable for sewage disposal installation _____ sq. ft.
Source of Water Supply well to be No. Lavatories _____
No. Bedrooms 2 No. Showers or Tubs _____ No. Baths _____
No. Garbage Grinders no No. Automatic Washers ✓

SEPTIC TANK

precast Jblin
Material _____ Length _____ x Width _____ x Depth _____ = _____ cubic feet
Liquid Depth _____ ft. Liquid Capacity 1000 gal.
Distance to: Dwelling 20+ Water Supply to be 50' Nearest Property Line road

SOIL ABSORPTION SYSTEM

Type Drain Line Material plastic 405 Trench Width 36 in Inches
Trench Depth 28 in Inches Total Absorption area in Trench Bottom 630 sq. ft.
Diameter of Drain Line 4 Inches Type Filter Media gravel
No. of Drain Lines 4 Depth Filter Media Under Drain Line 6-8 Inches
Length of Each Line 55.55.55.55 ft. Depth Filter Media Over Drain Line 2 in
Distance of Disposal Field to: (a) Dwelling 40
(b) Water Supply 100 (c) Nearest Property Line road


An inspection of the septic tank system described herein disclosed that said system (MEETS, DOES NOT MEET) the minimum standards established by the West Virginia State Department of Health.

10-24-83
Date

CDavid Dunlap RS
Sanitarian

SKETCH OF SYSTEM TO BE DRAWN ON BACK

Note: Copy of this inspection report must be given to owner and the original filed in the Health Department files. PERMANENT RECORD - DO NOT DESTROY.

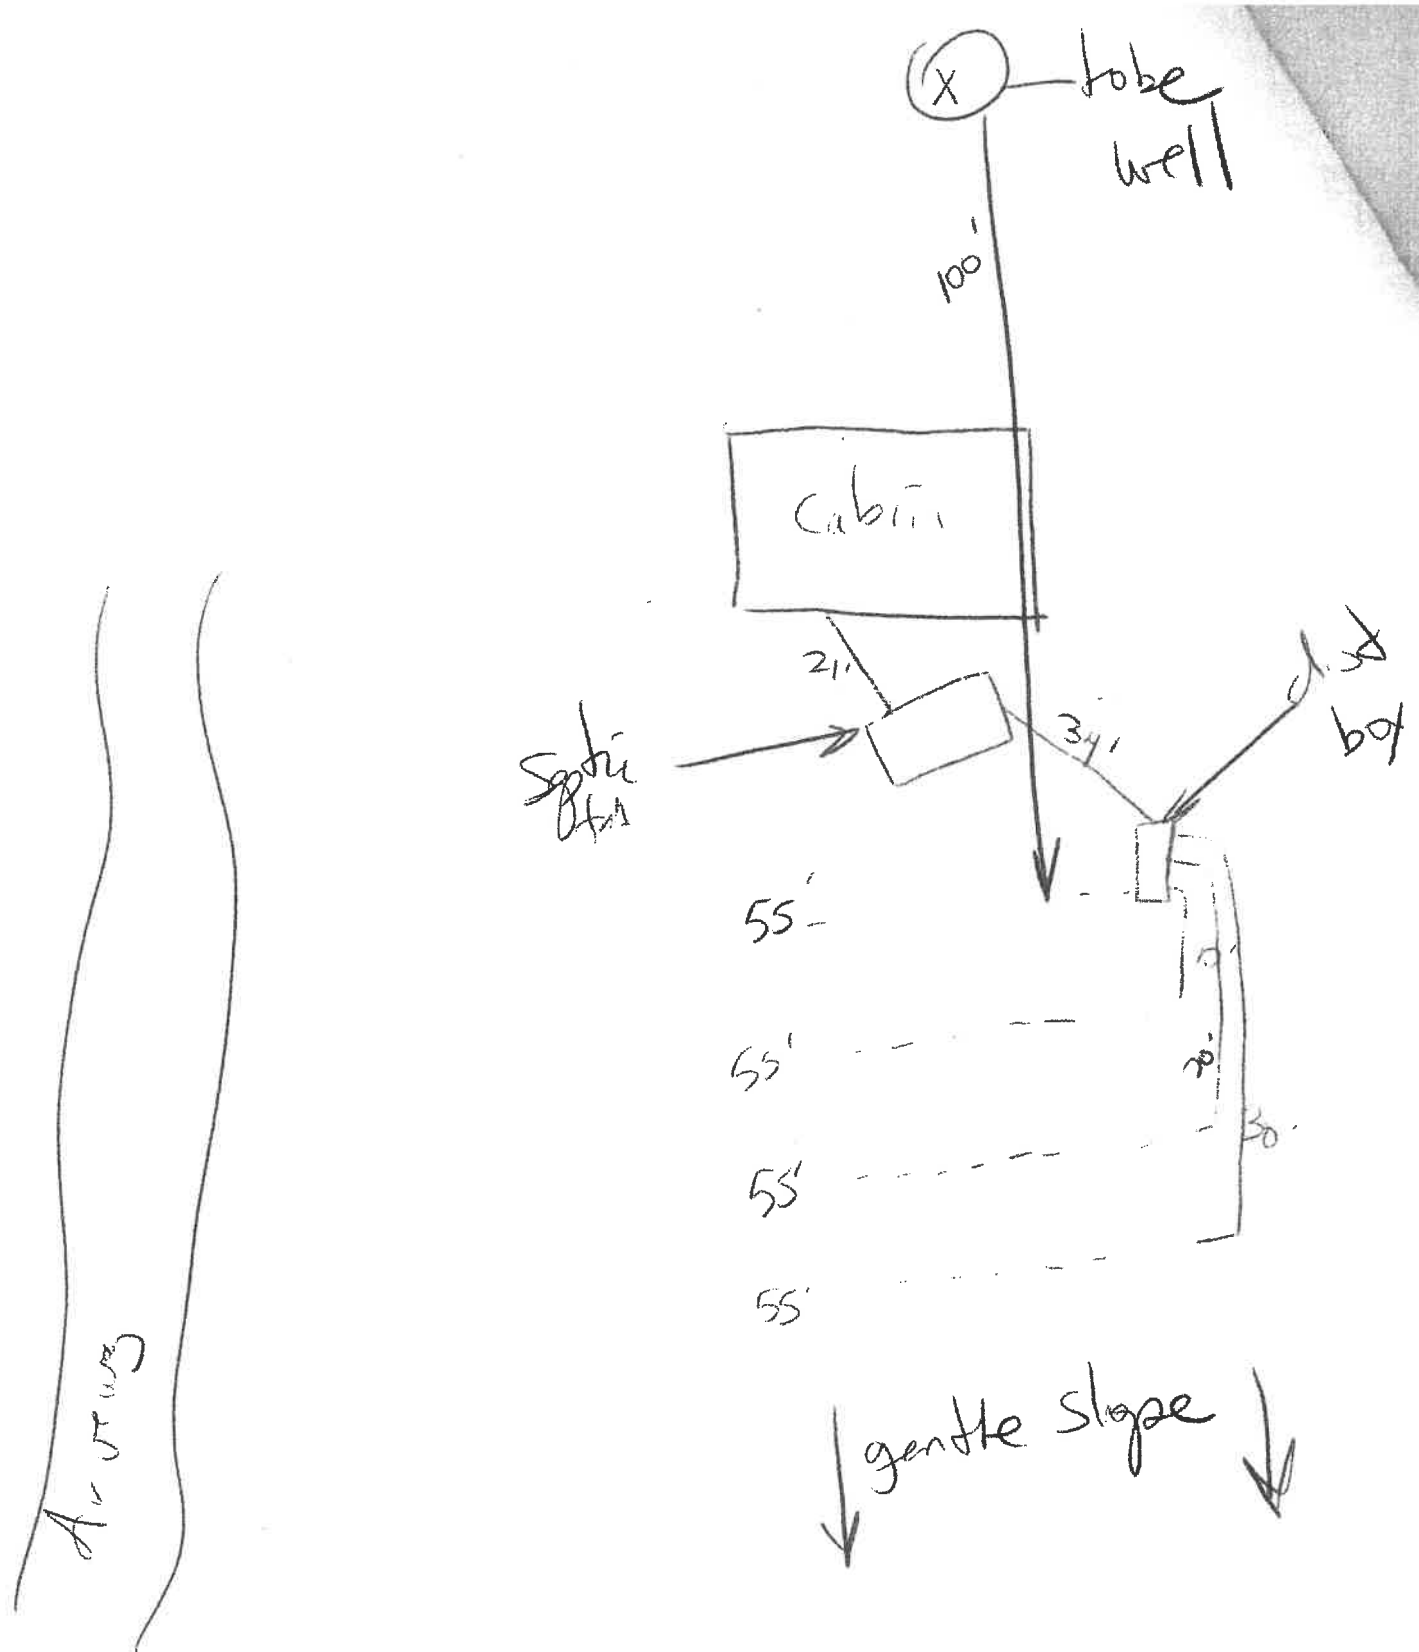

County Road



Pin Oak

David Dinkers