

INSPECTION TO BE
PRINTED OR TYPED

STATE OF WEST VIRGINIA

HEALTH DEPARTMENT

ON-SITE SEWAGE DISPOSAL SYSTEM
INSPECTION FORM

Permit No.: ST-17-06-440
Tax Map: 16 Parcel #: 0013
County Road: _____

County: W. Virginia

Name of Owner: JOHNNY & LORI THOMAS Installer: WALTER FIELDS
Address: 6. BOBINETTE HILL, AMHERSTDALE WV 25607
Property Location: GREENFIELDS EST LOT #58
Type of Facility: RESIDENCE Facility is: New ☒ Existing () Lot Size: 2.50 Sq. Ft. (Acres)
Design Loading in gpd/No. Bedrooms: 3 Source of Water Supply: PUBLIC

SEWAGE TANK COMPONENT

Capacity in Gallons: 1000 Material: Concrete Manufacturer: _____
Distances (in feet) of Tank to: Dwelling: 10+ Private () / Public ☒ Water Source: 50+ Property Line: 150+

ON-SITE DISPOSAL SYSTEM

Class I Systems: Standard Soil Absorption Trenches () or Bed () Gravelless Pipe (), Diameter: _____ Inches
Chamber Soil Absorption Trenches () or Bed ()
Class II Systems: Pumped/Dosed Soil Absorption Trenches () or Bed () Evapotranspiration Trenches () or Bed ()
Shallow Soil Absorption Trenches () or Bed () Other: _____


No. of Lines: 5 Length (in feet) of Each: 80, 80, 80, 80, 80, _____
Width of Trenches: _____ inches/feet Depth to Bottom of Field: 24 inches
If Bed, Dimensions (in Feet): _____ If Chamber System, Name: _____, No. of Units: _____
Approved and Adequate Materials Used? Yes ☒ No () Size Equates to: 2000 Square Feet of Standard Gravel Field.
Distances (in feet) of System to: Dwelling: 30 Private () / Public ☒ Water Source: 60+ Property Line: 20+
Remarks: _____

An inspection indicates that the sewage disposal system described above **DOES MEET** ☒, **DOES NOT MEET** (), **CANNOT BE DETERMINED TO MEET** () the minimum standards established by the West Virginia Bureau of Public Health.

To correct a health hazard, modifications to existing systems may be done to improve part of a system. Such modifications may not be able to be designated as a **does meet** system since inadequate information is known.

Although many factors contribute to the successful functioning of a sewage disposal system, this office recommends water conservation and maintaining an even usage of water throughout the week.

Sketch of Installation with Triangulation or Distance to Specific Landmarks:

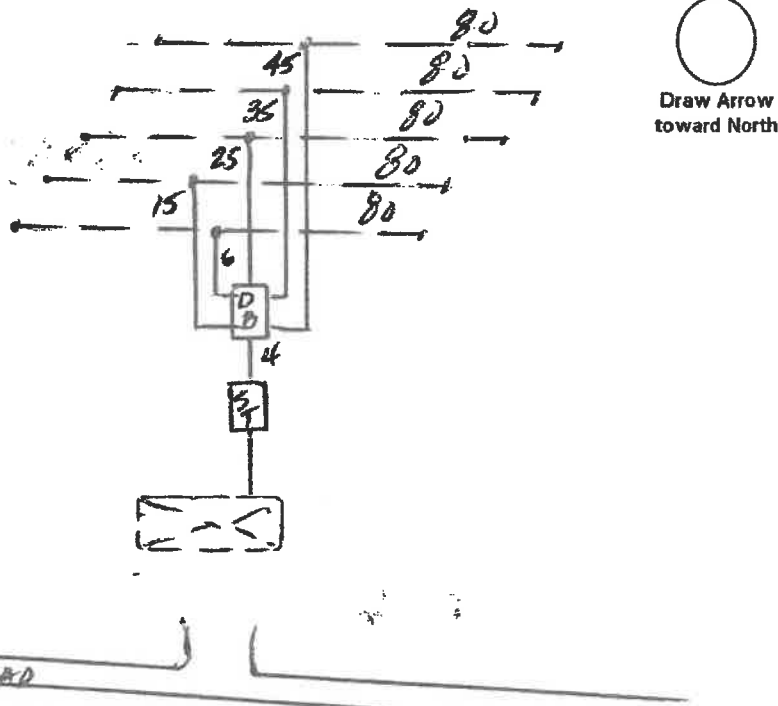

Visit Date(s): 5-2-06
Final Inspection Date: 6-13-06

Sanitarian: D. Naketh