

**SURRY COUNTY HEALTH DEPARTMENT  
OPERATIONS PERMIT**

Owner Joseph Persky Permit No. HR05039604  
 Location Wandering Walk, Lowgap END OF CUL-DE-SAC  
straight of hill to end.  
 Parcel ID # 4061-8705 Lot Size 17 ACRES

**SEPTIC TANK SYSTEM DESIGN**

Use of Structure: HOUSE  
 No. of Bedrooms: 2  
 Water Supply: Private System  ✓  
                   Public System \_\_\_\_\_  
 No. of Employees NA No. of Seats NA  
 Basement: yes  no  
 Basement plumbing: yes  no


Size of Tank 1000  
 Dist. to prop. line \_\_\_\_\_  
 Dist. to well 100' +  
 Dist. to foundation 40'  
 Nitrification Field 600 Sq. Ft.  
 No. of Lines 3  
 Width of Lines 4'  
 Length of Lines 50'  
 Depth of Stone 12"

Bobby Beck  
 CONTRACTOR

SPECIFICATIONS: Well is way down hill to left of drive  
coming in.

Date August 22nd 97

Hal E. Robinson R.S.  
 Env. Health Specialist

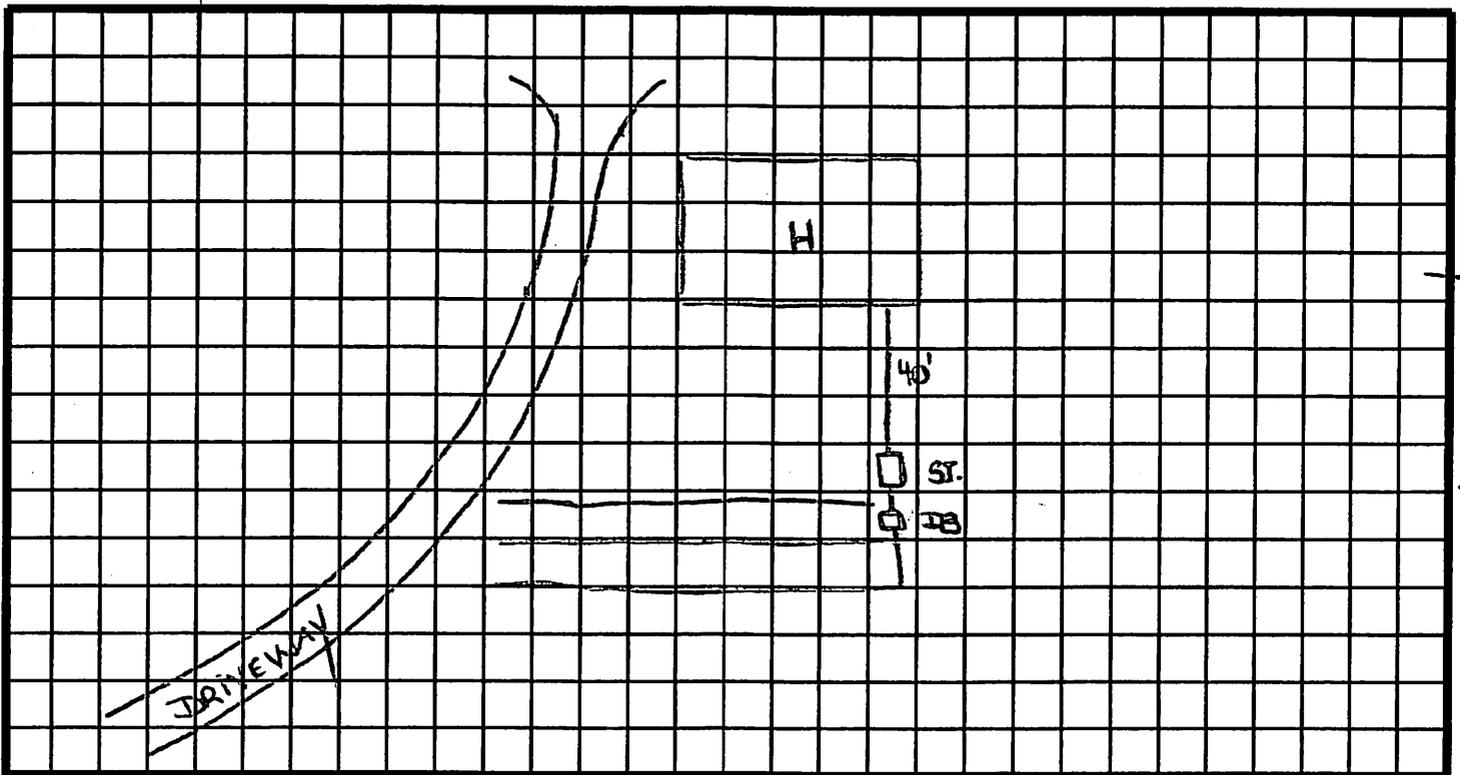

**SURRY COUNTY HEALTH AND NUTRITION CENTER**

**Operations Permit**



Applicant's Name: Joseph Persky PIN: 4061-00-62-8705 Permit Number: JF012910-01

Site Address: 400 Caseys Crossing

Subdivision: \_\_\_\_\_ Lot Number: \_\_\_\_\_


Directions to Site: Round Peak Ch Rd / L on Flippen Rd / R on Wandering Walk

EHS Name: Johnny Easter Date Issued: 31110

Authorized State Agent: Steve Simiondo, REHS Date: 12-14-12

Septic Contractor: Matt Bare Date Issued: 31110

IP/CA Issued by: JR Freborg Date Issued: 112910

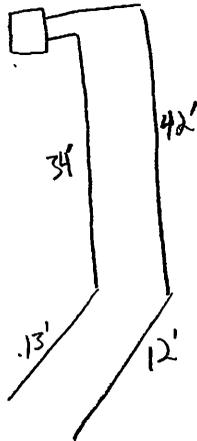

**SYSTEM SPECIFICATIONS**

Facility Type: SFR  New  Expansion  Repair  
 Daily Design Flow: 120 GPD Number of People: \_\_\_\_\_ Number of Occupants: \_\_\_\_\_  
 Number of Bedrooms: \_\_\_\_\_ (Members/Employees) Type of Water Supply: private well  
 Initial System Type: 25% red Initial LTAR: 0.3 Repair System Type: 25% Repair LTAR: 0.3

**TANK INFORMATION**

Septic Tank ID: existing Liquid Capacity: \_\_\_\_\_ ga Date of Manufacture: \_\_\_\_\_ / \_\_\_\_\_ / \_\_\_\_\_  
 Pump Tank ID: \_\_\_\_\_ Liquid Capacity: \_\_\_\_\_ ga Date of Manufacture: \_\_\_\_\_ / \_\_\_\_\_ / \_\_\_\_\_  
 Filter Type: \_\_\_\_\_

**NITRIFICATION FIELD**

Total Trench Length: 101 feet Trench Depth: \_\_\_\_\_ inches Trench Width: \_\_\_\_\_ inches  
 Aggregate Depth: \_\_\_\_\_ inches Trench Spacing: \_\_\_\_\_ feet on center

**PUMP SPECIFICATIONS**

Total Length of Supply Line: \_\_\_\_\_ feet TDH: \_\_\_\_\_ feet Dosing Volume: \_\_\_\_\_ gallons  
 Diameter of Supply Line: \_\_\_\_\_ inches Drawn Down: \_\_\_\_\_ inches Anti-siphon Hole:  yes /  no  
 Vent Hole:  yes /  no Valves Accessible:  yes /  no Check Valve:  yes /  no Ball/Gate/Globe Valve:  yes /  no  
 Threaded Union:  yes /  no Rope or Stainless Steel Chain:  yes /  no Alarm Audible & Visible:  yes /  no  
 NEMA 4X box (or equivalent): \_\_\_\_\_ in. above finished grade Riser: \_\_\_\_\_ in. above finished grade

