



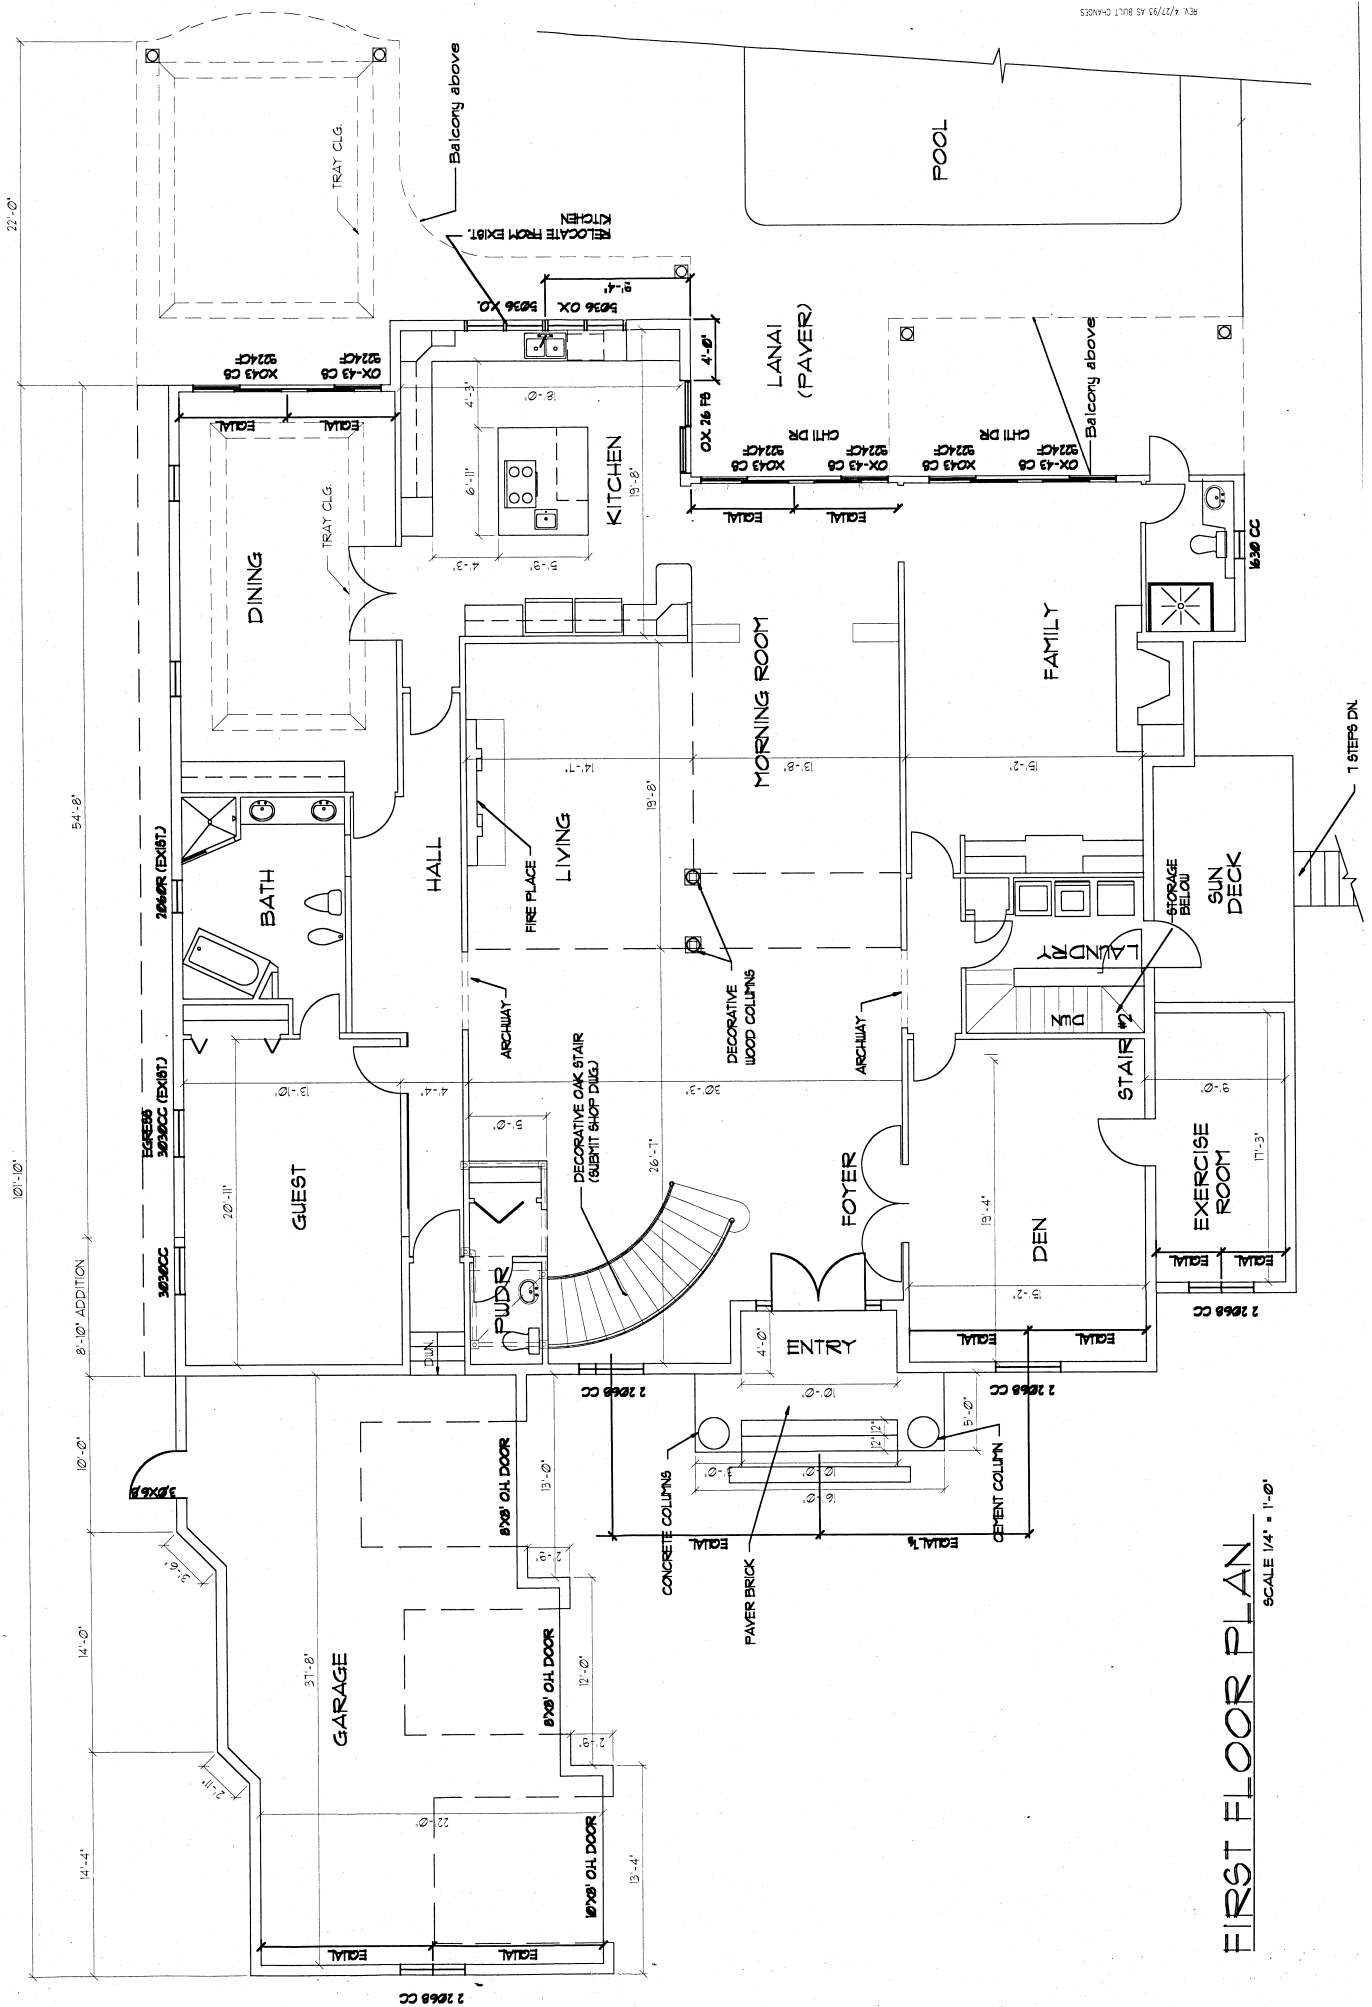

FIRST FLOOR PLAN
 SCALE 1/4" = 1'-0"

REV 4/27/93 AS BUILT CHANGES

106'-0"

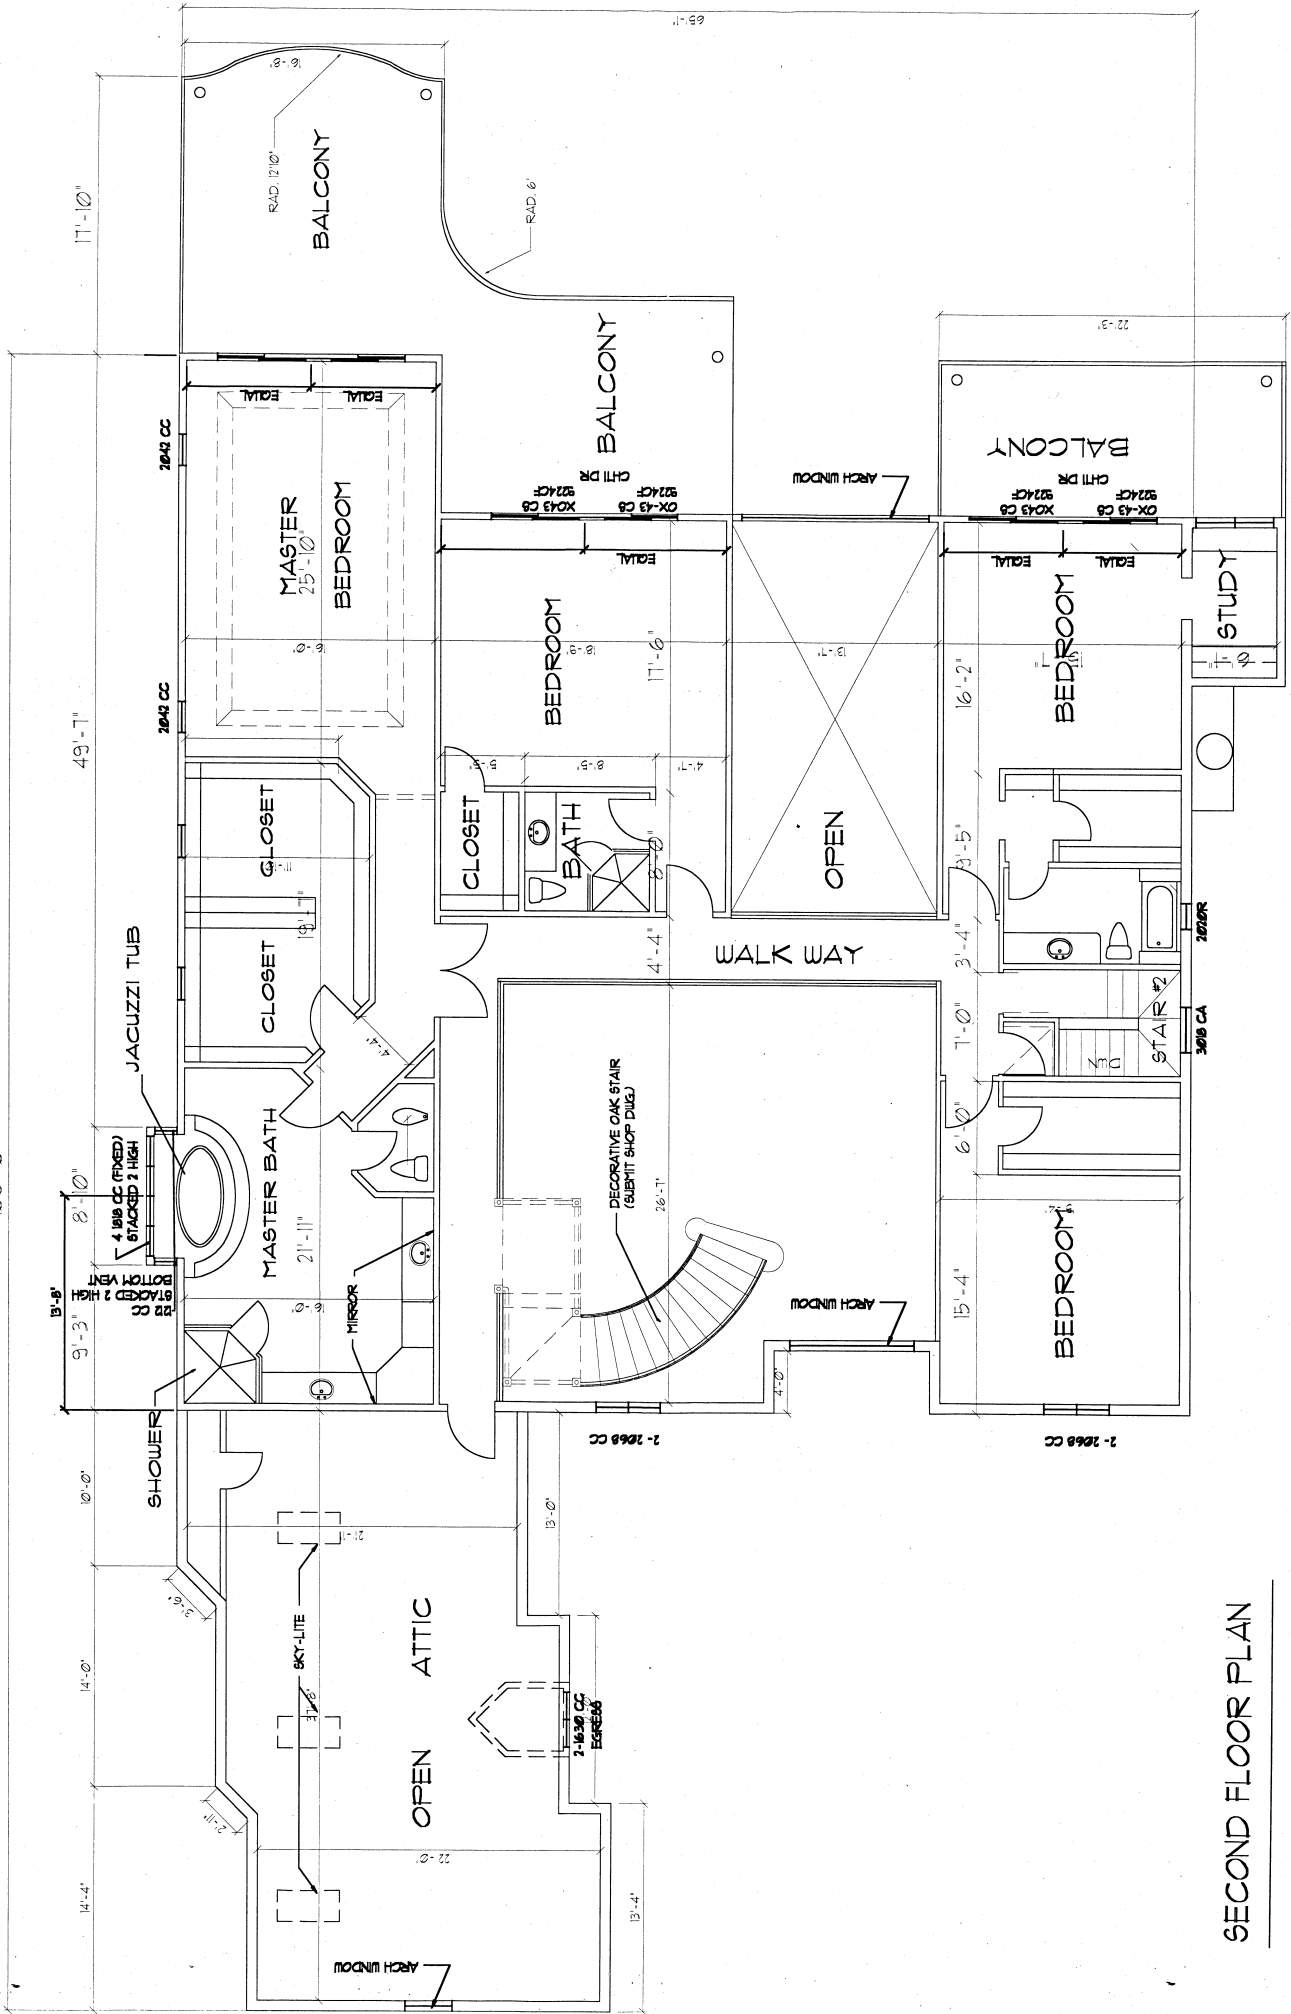

SECOND FLOOR PLAN

SCALE : 1/4" = 1'-0"