

GRANVILLE-VANCE HEALTH DEPARTMENT—Sewage Disposal Record

Owner or Contractor John Copland Date 6-12-00 S.R. No. 1307
 Location/Address 6071 Bob Daniel Rd.
 Subdivision/Mobile Home Park Name _____ Lot Size _____
 Permit No. # 2569 Lot No. _____

New System _____ Repair ☒
 House ☒ Mobile Home _____ Business _____
 No. Bedrooms 3 No. People 4 No. Toilets _____
 Water Supply: Private ☒ Approved _____
 Semi-Public _____ Unapproved _____
 Public _____ None _____

Nitrification System:

Tank Size _____ gal. existing
 Distribution Box ☒ No. Lines 3
 Nitrification Field 900 Sq. Ft.
 Lines:


	1	2	3	4	5	6
Width	<u>3'</u>	<u>3'</u>	<u>3'</u>			
Length	<u>100'</u>	<u>100'</u>	<u>100'</u>			
Grade	<u>0"</u>	<u>0"</u>	<u>0"</u>			
Stone Depth	<u>12"</u>	<u>12"</u>	<u>12"</u>			

Layout to be followed by installer:


Improvements Permit By Eddie Yount Installer Norman Clifford
 Certificate of Completion By Eddie Yount Date of Inspection 6-12-00

* Construction must comply with all other applicable state and local regulations, but the permit is not a guarantee that the system will not malfunction and the Granville-Vance Health District will not be held responsible for a malfunctioning system.

NOTE: Make sketch of installation showing location of house, septic tanks, privies, water supplies on adjacent property, etc. Write in measurements in order that installations may be located at later date.

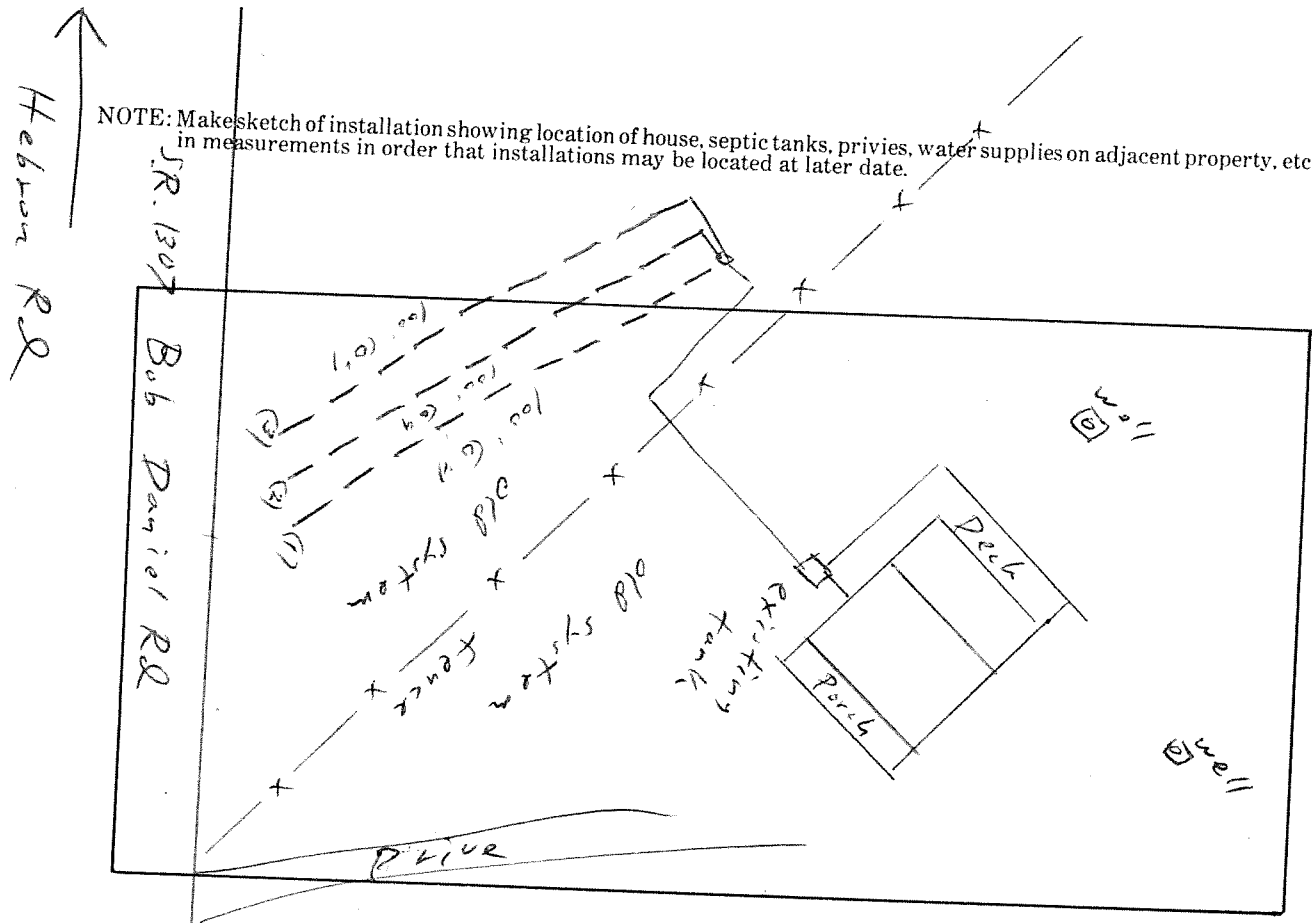

Granville County, NC

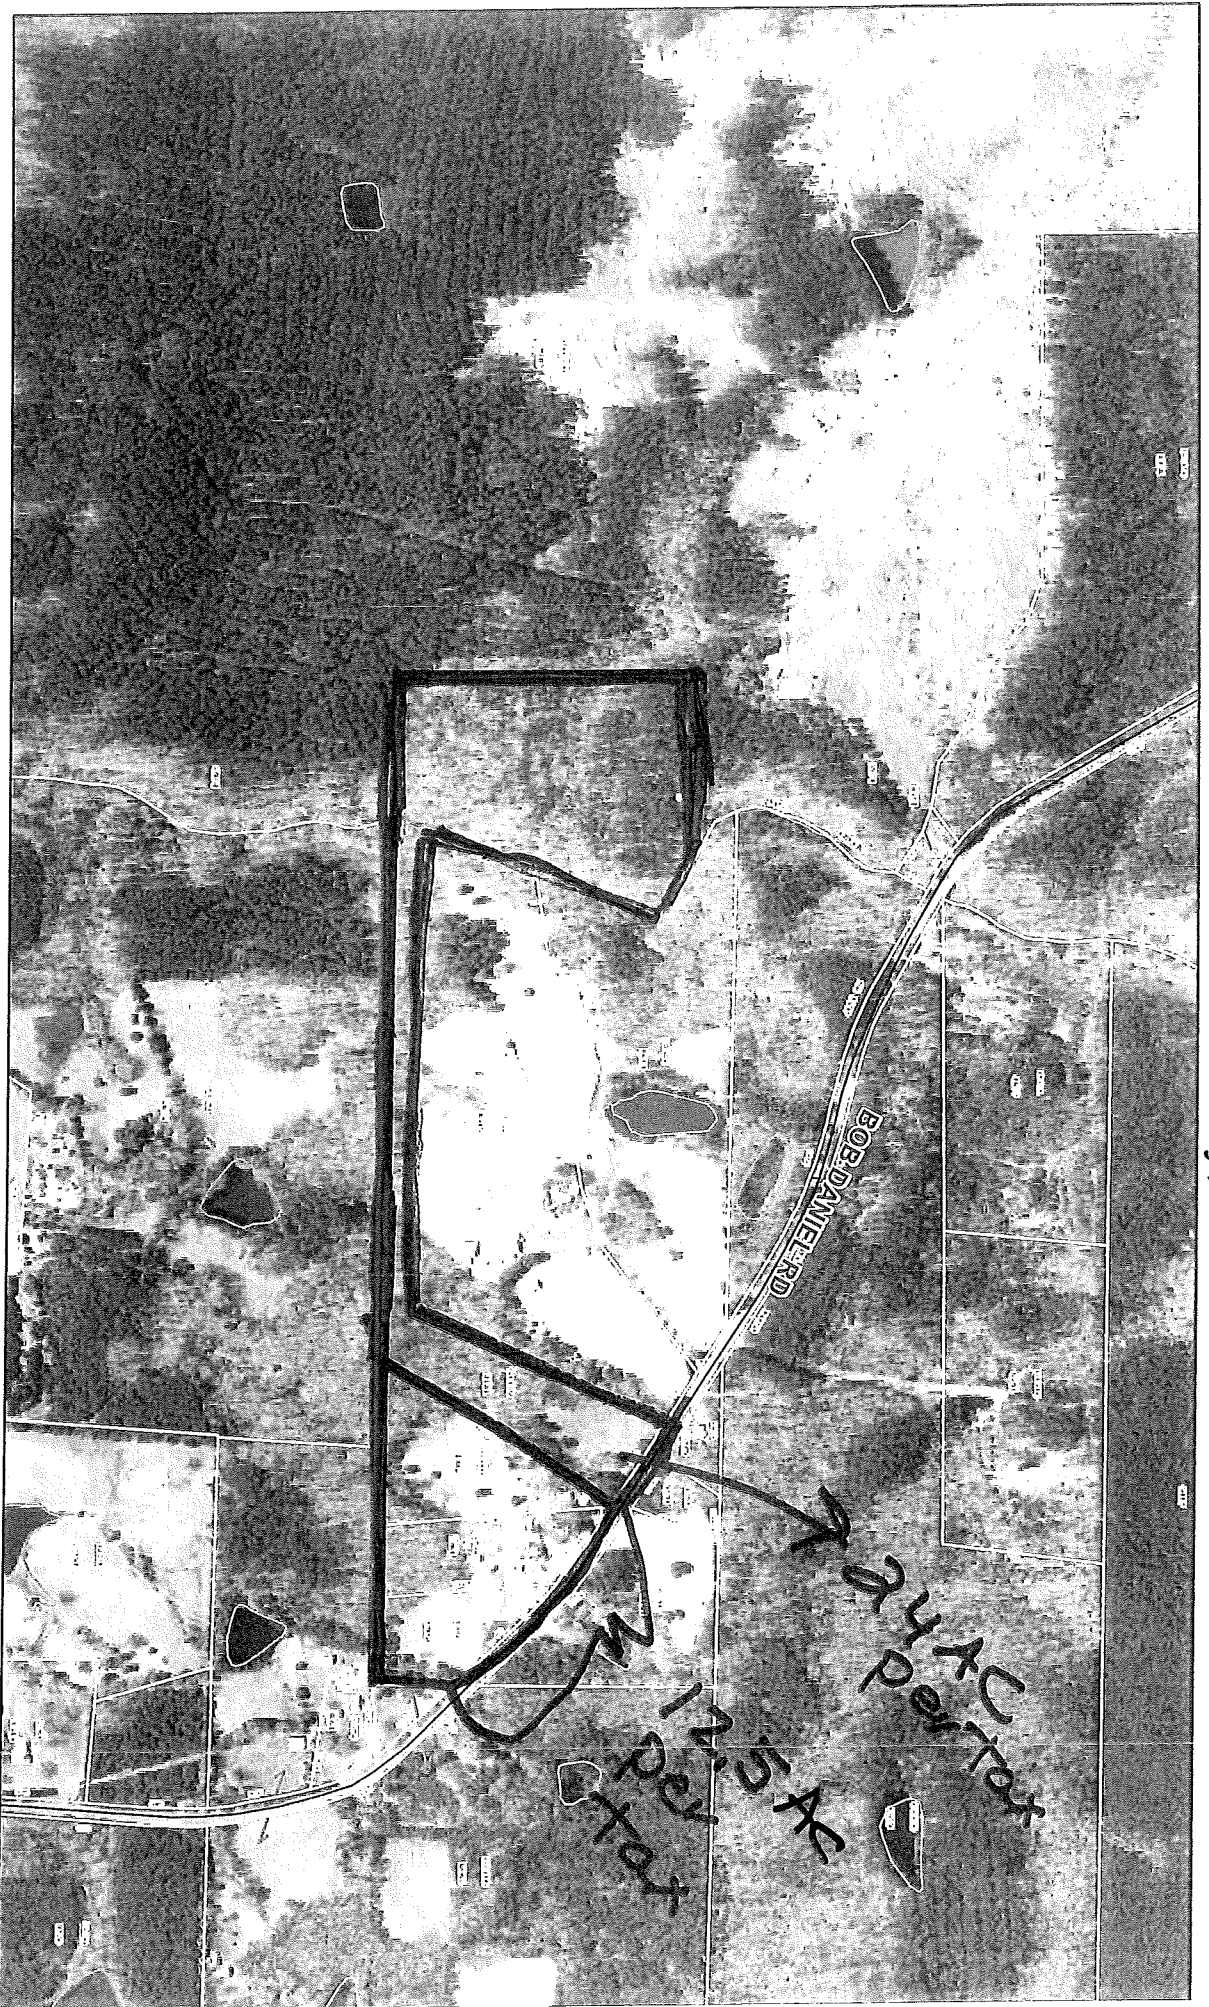

8/7/2022, 2:29:43 PM

Centerlines

Leaders

Imagery Latest

Blue: Band_3

Parcels

Parcel Hooks

Red: Band_1

Hydro

granville_nc_anno

Green: Band_2

