

2100 Summer Ave

Aberdeen, WA 98520

Phone 532-0631

WYS HARBOR HEALTH DISTRICT

(DIRECTIONS ON BACK)

Owner: Russell E. Darrin
Attn: BOX 236 Aberdeen, Wa.

Applicant: _____
 (Please Print Name)

SAME

(Applicant Signature)

Mail Report To: SAME

Sewage Contractor: SELF

System Designer

Legal Description: LOT 2, VIENNA TRACTS

Lot _____ Blk _____ Div _____
 Sec. 10 Twmsp 18 N Range 9 W
 Parcel No. 82900000100

Type of Building M-H No. of Bedrooms 3 Lot Size 4 A

Commercial: Liquid Waste G.P.D. _____

Water System

☒ Community ☐ Single Family Only

Name ABRD I.D. # _____

Basement Plumbing ☐ Yes ☒ No

Directions to Site: NORTH ON WISHKAH ROAD
TO ABERDEEN GARDENS ROAD & ABOUT
1/2 MILE NORTH TO SITE ON RIGHT
OF ROADWAY.

Fee (Non Refundable) \$120.00

Site Permit No. 149

Area: Wishkah Valley

Date	Amount	Receipt Number
<u>7-9-85</u>	<u>NW</u>	<u>120.00</u>
		<u>43053</u>

This Site Permit Expires: 7-11-87

Date	Record of Action	By
<u>7-11-85</u>	<u>on-site</u>	<u>DG</u>
<u>9-9-85</u>	<u>Final good job</u>	<u>DG</u>

Date: 7-11-85 Site: ☒ Approved ☐ Disapproved
 By: Douglas Lerge

Date: _____ Special System: ☐ Approved ☐ Disapproved
 By: _____

SCS Soil Type silt/loam

Depth of Water Table 24 Ft. Month _____

Perc Tests _____ Minutes Per Inch _____

By: _____ Date _____

Primary Septic Tank(s) 1000 Gal. Pump Req. _____

Distribution Tile Total 265 Feet


Filtration Area 795 SQ Feet

Stone over Tile 2 Inches

Stone under Tile 6 Inches

Width of Trench 36 Inches

Any WELLS located on or within 100 feet of the property must be indicated on SKETCH.

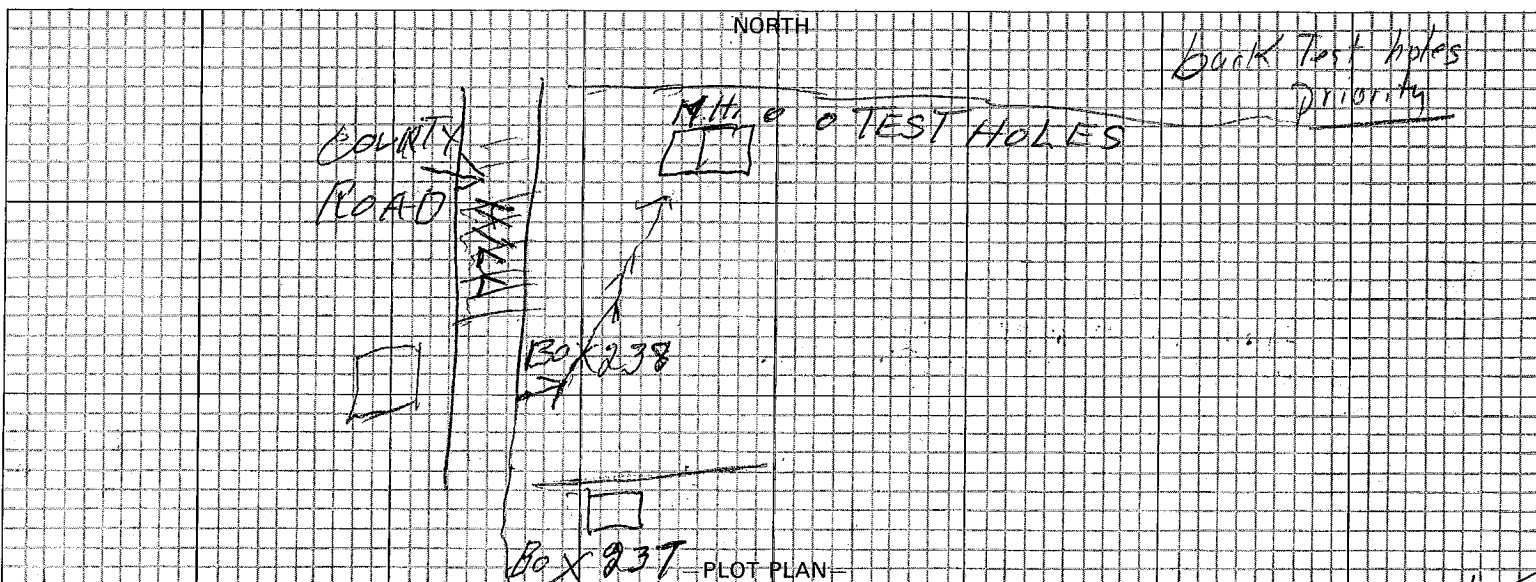

NOTICE: THIS IS NOT A PERMIT TO INSTALL

Permit #15007

PARCEL # _____

ADDRESS _____ TWNSP _____ SEC _____ RG _____ 15007

INSTALLATION DATE 9-9-85 SEWAGE CONTRACTOR Self



SEPTIC TANK SIZE 1000 CUBIC YARDS ROCK _____ SPACE RESERVED FOR REPLACEMENT FIELD _____ SQ. FT.

THIS RECORD IS NOT A GUARANTEE OF PERFORMANCE. THE DEPARTMENT RECOMMENDS THE SEPTIC TANK ITSELF SHOULD BE INSPECTED EVERY THREE TO FIVE YEARS, DEPENDING ON HOW THE DRAINAGE IN THE AREA IS. REDUCTION IN HOUSE WATER USE WILL PROLONG THE DRAINFIELD LIFE.

100'

INDICATE THE FOLLOWING INFORMATION, IF KNOWN, ON THE DRAWING:

1. RESIDENCE LOCATION AND DIMENSIONS.
2. PAVED SURFACES (I.E., PATIOS, DRIVEWAYS, ETC.)
3. WELLS OR SURFACE WATER SOURCES.
4. DIRECTIONS OF DRAINAGE.
5. SEPTIC SYSTEM LOCATION AND DEPTH TO TOP.
TANK LOCATION — FROM HOUSE
DRAINFIELD LENGTH AND LOCATION
LOCATION & LENGTH OF ALL TIGHT LINES
6. LENGTH, LOCATION & DIMENSIONS OF ALL INTERCEPTOR LINES.
7. LABEL ALL SETBACKS, I.E. FROM WATER, PROPERTY LINES, COUNTRY ROADS, ETC.
8. ASSUME AN ELEVATION OF 100 FEET AT ONE LOT CORNER AND INDICATE THE OTHER LOT CORNER ELEVATIONS TO IT.
9. USE ARROWS TO SHOW DIRECTION OF SLOPE
ONE SQUARE EQUALS 10 FEET

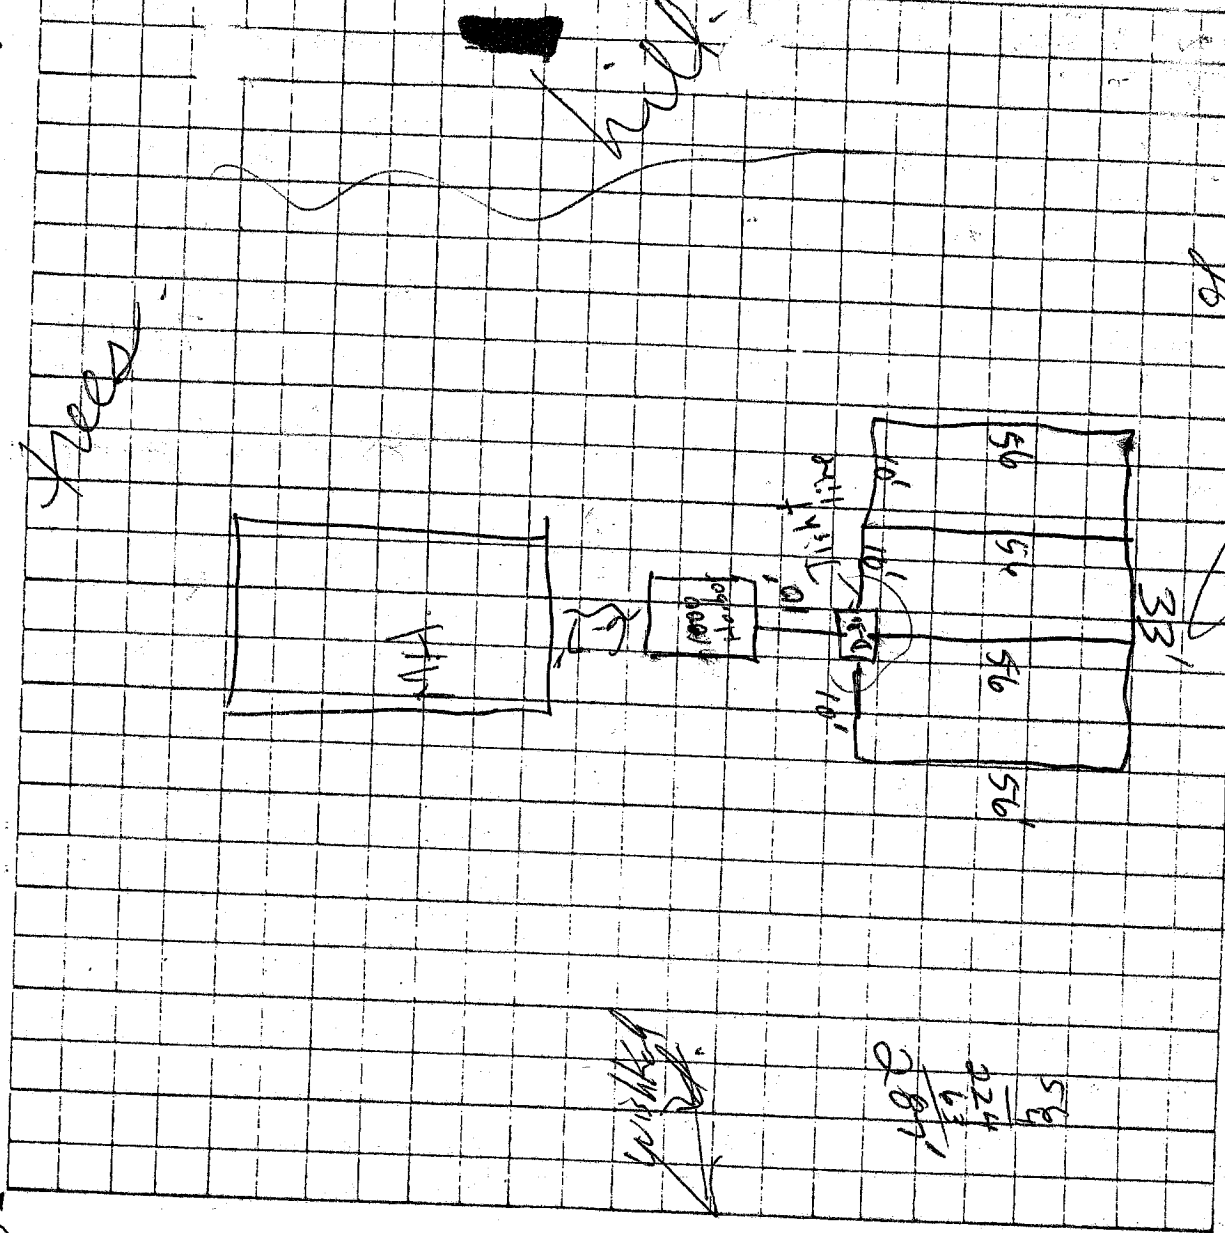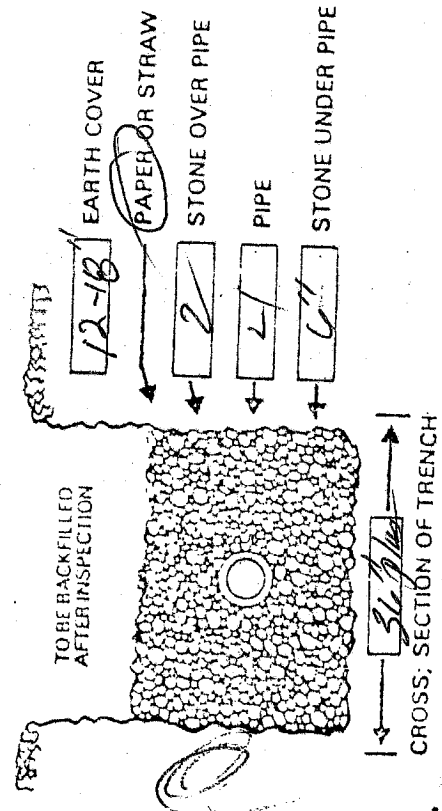

DATE 9-9-85

CERTIFIED BY _____

APPROVED BY Danston & Son