

☒ Improvement Permit
☐ Operation Permit ☐ Authorization
☐ Certificate of Completion

(This permit expires three years from date of issue.
 Construction is not to begin until all applicable
 permits have been issued.)

NAME WILBUR J. FRENCH
 PROPERTY ADDRESS RT. 1 Box 419 (QUAQUA CREEK RD.)
 DIRECTIONS TO ADDRESS 29 MILES N. @ ORANGE HILL RD. @ ESTERS RD. @ QUAQUA CREEK RD. to END
 SUBDIVISION _____ LOT NO. _____ SECTION _____ LOT SIZE _____
 SQUARE FOOTAGE/ACREAGE 1.1

1. ☒ HOUSE ☒ BEDROOMS
 2. ☐ MOBILE HOME ☐ ROOMS
 3. ☐ BUSINESS ☐ NO. PERSONS
 4. ☐ APT/CONDO ☐ BATHROOMS
 5. ☐ OTHER ☐ BASEMENT

False statements or misrepresentations supplied in the
 issuance of this permit, or any significant change in site
 conditions from those evaluated is cause for permit
 suspension or revocation (GS 130A-23a, c, d)

TYPE SYSTEM
☒ NEW A. ☒ CONVENTIONAL
☐ REPAIR B. ☐ L.P.P.
 C. ☐ SAND FILTER
 D. ☐ PIT PRIVY
 E. ☐ OTHER (SPEC)

INSTALLED BY
BILLINGSLEY


SOLID WASTE DISPOSAL METHOD

SELF

LAYOUT	SPECIFICATIONS	INSTALLED
1000	TANK SIZE	1000
810 sq. ft.	TANK NO.	769
WELL	DRAINFIELD SQ. FOOTAGE	810 sq. ft.
3 @ 90'	WATER SUPPLY	WELL
3/4"	NUMBER OF LINES	3 @ 90'
10"	TRENCH WIDTH	3/4"
12"	DEPTH OF ROCK UNDER PIPE	6"
10'	TOTAL ROCK	12"
10'	DISTANCE TO FOUNDATION	10'
100'	DISTANCE TO PROPERTY LINES	10'
N/A	DISTANCE TO WELL	100'
N/A	ZONING JURISDICTION	N/A
N/A	WATER SHED	N/A

NOTES ON LAYOUT (DESCRIPTION) (1) MAXIMUM TRENCH DEPTH 24" (2) LATERALS MUST GO ON CENTS
OF LAND (3) Keep Septic System A MINIMUM OF 75' from well.

REPLACES PERMIT # A-111333-1

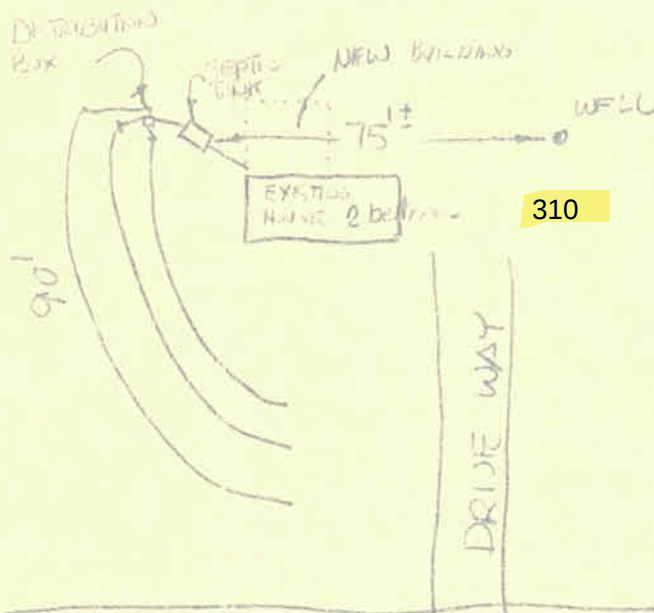

SYSTEM
 INSTALLED
 AS
 INDICATED

S.R. 2024 QUAQUA CREEK Rd.

IMPROVEMENTS PERMIT BY:

Harren Richardson

TITLE

12-10-96

DATE

CERTIFICATE OF COMPLETION BY:

Harren Richardson

TITLE

12-10-96

DATE

ROCKINGHAM COUNTY HEALTH DEPARTMENT

NO. 107/493-2



☒ Improvement Permit ☐ Authorization
☐ Operation Permit ☒ Cert. of Completion

Improvement permit expires five years from date of issue. Construction is not to begin until all applicable permits have been issued.

NAME Wilbur French ADDRESS Route 1, Box 419, Ruffin, NC. 27326
 PROPERTY ADDRESS Qua Qua Creek Road - Rt. 1, Box 419, Ruffin
 DIRECTIONS TO PROPERTY Estes Road to Qua Qua Creek Road
 SUBDIVISION _____ LOT NO. _____ SECTION _____ LOT SIZE 104.98 acres
 TAX PIN 8928-00-92-1810 SQUARE FOOTAGE/ACREAGE _____

☒ HOUSE	☒ 3 BEDROOMS	LAYOUT <u>4. tank + tee</u>	SPECIFICATIONS <u>new tee</u>	INSTALLED
☐ MOBILE HOME	☒ 3 NO. PERSONS	<u>Existing</u>	TANK SIZE <u>EXIST</u>	TANK NO. <u>Existing</u>
☐ BUSINESS	☐ BATH	<u>1,200 sq. ft.</u>	DRAINFIELD SQ. FOOTAGE	<u>1,200 sq. ft.</u>
☐ APT/CONDO	☒ BASEMENT	<u>well</u>	WATER SUPPLY	<u>well</u>
☐ OTHER	☒ BASEMENT	<u>1 (4 segments)</u>	NO. OF LINES	<u>1 (4 segments)</u>
	w/ PLUMBING	<u>400' (20', 20', 20', 20')</u>	TOTAL LENGTH OF LINES	<u>400' (120', 110', 10', 70')</u>
TYPE SYSTEM <u>shallow</u>		<u>18" - 24"</u>	TRENCH DEPTH	<u>shallow 18" - 24"</u>
☐ NEW	A. ☒ CONVENTIONAL	<u>36"</u>	TRENCH WIDTH	<u>36"</u>
☒ REPAIR	B. ☐ L.P.P.	<u>6"</u>	DEPTH OF ROCK UNDER PIPE	<u>6"</u>
	C. ☐ SAND FILTER	<u>12"</u>	TOTAL ROCK DEPTH	<u>12"</u>
INSTALLER <u>Billingsley</u>	D. ☐ PIT PRIVY	<u>60'</u>	DISTANCE TO FOUNDATION	<u>60'</u>
	E. ☐ OTHER (SPEC)	<u>210'</u>	DISTANCE TO PROPERTY LINES	<u>210'</u>
		<u>100'</u>	DISTANCE TO WELL	<u>100'</u>
		<u>county</u>	ZONING JURISDICTION	<u>county</u>
		<u>No</u>	WATER SHED	<u>No</u>
SOLID WASTE DISPOSAL METHOD				

NOTES ON LAYOUT (DESCRIPTION) on contour. Landscape promptly to prevent erosion. Pump out tank and check tank and tee.
 THIS PERMIT IS SUBJECT TO REVOCATION IF THE SITE PLANS OR THE INTENDED USE CHANGES.
75 ft. of sched. 40 to drainfield

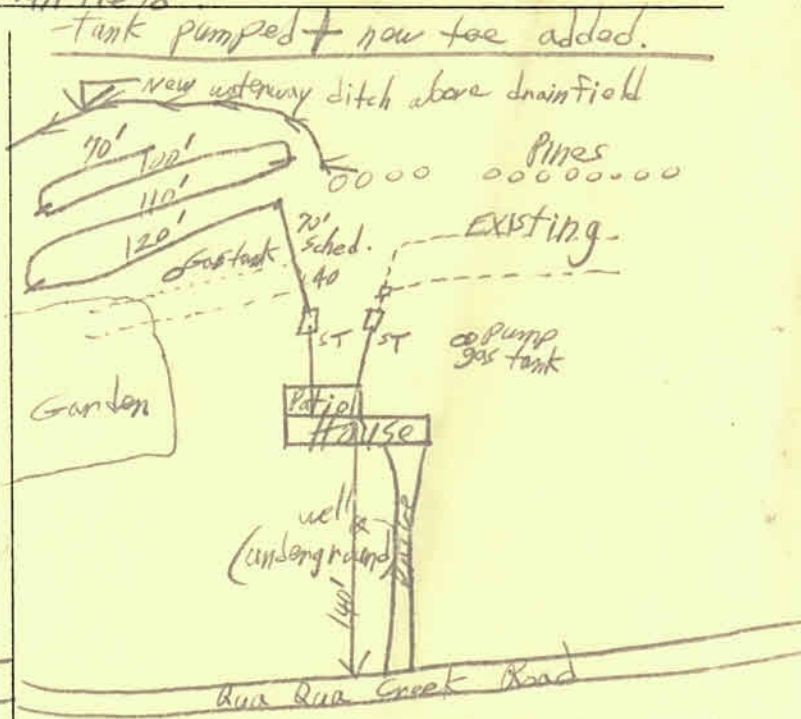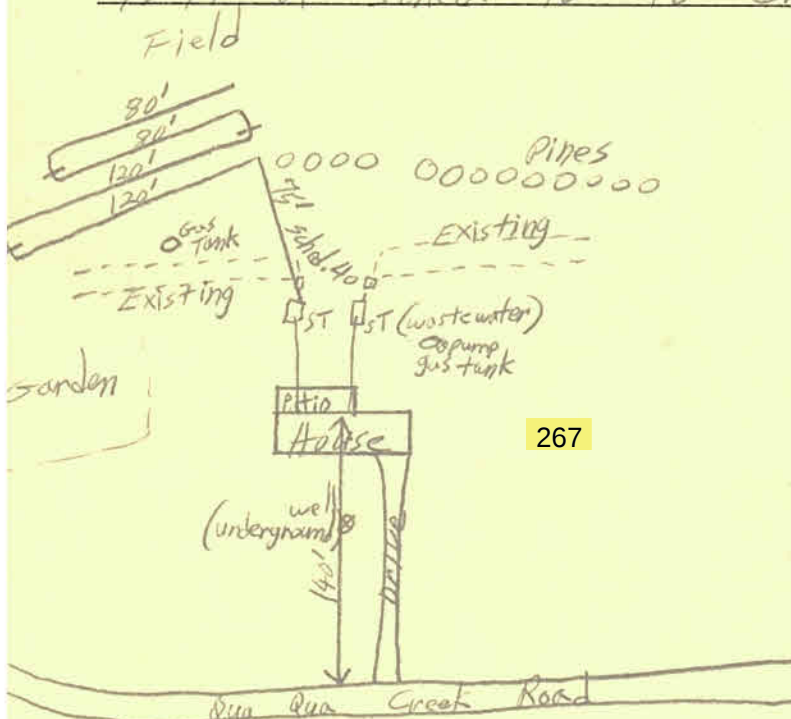

267

IMPROVEMENT PERMIT BY: L.F. Nelson, Jr. DATE July 14, 1993
 TITLE _____

CERTIFICATE OF COMPLETION BY: L.F. Nelson, Jr. DATE Aug. 3, 1993
 TITLE _____

APPEALS: By written petition to the Office of Administrative Hearings, P.O. Drawer 27447, Raleigh, North Carolina 27611-7447. In accordance with GS.1508-23(a).

This permit may be suspended or revoked upon a finding that a violation of...this Chapter, The Rules...or a condition imposed upon the permit has occurred...Also upon a finding that its issuance was based on incorrect or inadequate information. GS.1508-23(a)(1)(d)

Rockingham County Department of Public Health

Permit Number: _____
 X Authorization for Wastewater System Construction (Expires five years from date of issuance of Imp)
 X Operation Permit _____ System Classification Type _____ Authorization to Connect to Wastew

TAX PIN NUMBER: 89280092181001 APPLICANT NAME: FRENCH

PROPERTY INFORMATION

345
 Road Name: QUA QUA CREEK ROAD
 Subd/Park:
 Section :
 Lot # :

Lot Size : 200A

Expiration Date : 12/30/03

OWNER INFORMATION

WILBUR J FRENCH
 267 QUA QUA CREEK ROAD
 RUFFIN NC 27326
 336 939 2891

Water Supply : PRIVATE WELL

--- TRANSFERABLE ---

OREGON HILL RD FROM OLD 29, TURN ON ESTES RD., PASS 3 BRICK HOUSES
 ON L. L. ON QUA QUA CREEK RD., SITE AT END OF ROAD.
 New septic tanks require effluent filter, risers, and markers. G.S. 130A-335(1)
 11-18-98

House	3 #bedrooms
X Mobile Home	#people
Business	#bath
Apt/Condo	basement
Other	basement w/ plumbing
TYPE SYSTEM	
X New	X Conventional
Repair	L.P.P.
	Sand Filter
	Pit Privy
	Other
IMP Name	Date
French	12/30/98

Permit subject to revocation if site plans/intended use changes.


B. Kingsley
 INSTALLER

INSTALLATION CONDITIONS

Install system on contour
 landscape promptly to minimize erosion
 and water ponding

LAYOUT	SPECIFICATIONS	INSTALLED
1000 gal	Tank size	# B. Kingsley 1000 STD 764
1200	Drainfield sq ft	1200
Pr. Well	Water Supply	Pr. Well
5-6	# of lines	6
400'	Total length of lines	30, 100, 75, 75, 60, 75
24"	Trench depth	24
36"	Trench width	36
6"	Depth of rock below pipe	6
12"	Total rock depth	12
25'	Distance to foundation	5'
>10'	Distance to property lines	>100
min 50	Distance to well	50
County	Zoning jurisdiction	County
	Water Shed	


AUTHORIZATION FOR WASTEWATER SYSTEM CONSTRUCTION

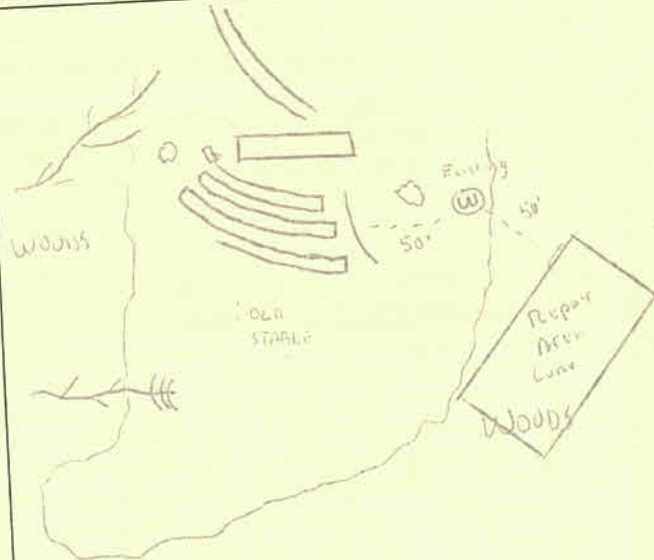

Signed: Jonathan Plummer I 1589

Date: 12/30/98

OPERATION PERMIT

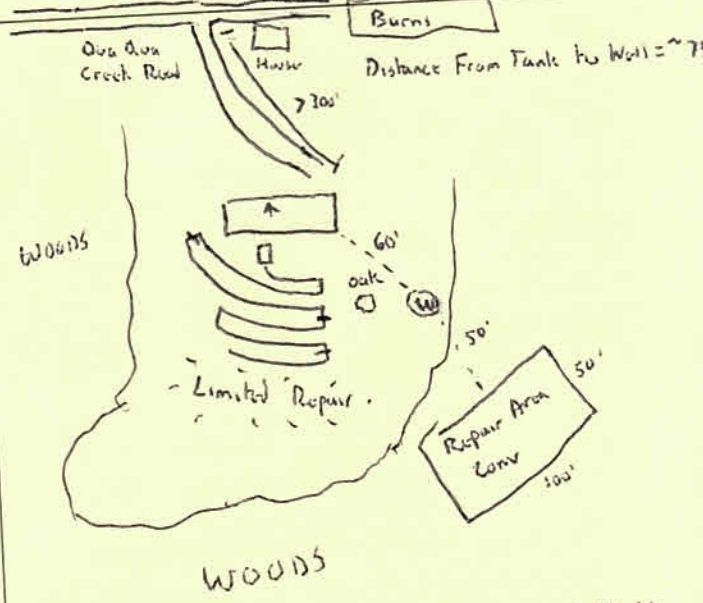

Signed: Jonathan Plummer I 1589

Date: 1-22-99

APPEALS: By written petition to the Office of Administrative Hearings, P.O. Drawer 27447, Raleigh, North Carolina 27611-7447. In accordance with GS. 150B-23(a) THE PERMIT may be suspended or revoked upon a finding that a violation of...this Chapter, The Rules... or a condition imposed upon the permit has occurred...Also upon a finding issuance was based on incorrect or inadequate information...GS. 130A-23(a)(c)(d).
 EH09TH96.

Jackson County Department of Public Health

Permit Number J6K040799-1

Authorization for Wastewater System Construction (Expires five years from date of issuance of Improvement Permit)

☒ Operation Permit IIa System Classification Type _____ Authorization to Connect to Wastewater System

☒ Improvement Permit

TAX PIN NUMBER: 89280092181000 APPLICANT NAME: FRENCH

WILBUR

J

PROPERTY INFORMATION

OWNER INFORMATION

Road Name: 267 QUA-QUA CREEK ROAD

WILBUR J FRENCH

Subd/Park: _____

267 QUA-QUA CREEK ROAD

Section: _____

RUFFIN

NC 27326

Lot #: _____

Lot Size: 104

Water Supply: PRIVATE WELL

Expiration Date: 04/07/04

-- TRANSFERABLE --

MT CARMEL CHURCH, RT ON OREGON HILL, LEFT ON ESTES, LEFT ON QUA-QUA CREEK RD, 1ST BRICK HOUSE ON LEFT, SITE NEAR HOUSE.
New septic tanks require effluent filter, risers, and markers. G.S.130A-335(i)

House	<u>3</u> #bedrooms
☒ Mobile Home	#people
Business	#bath
Apt/Condo	basement
Other	basement w/ plumbing

TYPE SYSTEM

☒ New	☒ Conventional
☐ Repair	☐ L.P.P.
	☐ Sand Filter
	☐ Pit Privy
	☐ Other

IMP Name W French Date 4/7/99

Permit subject to revocation if site plans/intended use changes.


Billingsley
INSTALLER

INSTALLATION CONDITIONS

- Install drainlines on contour of land
- Landscape promptly to minimize soil erosion & water ponding


LAYOUT	SPECIFICATIONS	12-22-98 INSTALLED
<u>1000gal</u>	Tank size	<u># Billingsley 500 700 1000</u>
<u>1200</u>	Drainfield sq ft	<u>1200</u>
<u>Per Well</u>	Water Supply	<u>Per Well</u>
<u>5-7</u>	# of lines	<u>6 (40, 70, 70, 100, 100, 20)</u>
<u>400'</u>	Total length of lines	<u>400'</u>
<u>* 22" *</u>	Trench depth	<u>✓</u>
<u>36"</u>	Trench width	<u>36"</u>
<u>6"</u>	Depth of rock below pipe	<u>6"</u>
<u>12"</u>	Total rock depth	<u>12"</u>
<u>> 5'</u>	Distance to foundation	<u>5'</u>
<u>> 10'</u>	Distance to property lines	<u>7 10</u>
<u>min 50</u>	Distance to well	<u>> 50 / Not Installed</u>
<u>County</u>	Zoning jurisdiction	<u>County</u>
	Water Shed	

AUTHORIZATION FOR WASTEWATER SYSTEM CONSTRUCTION

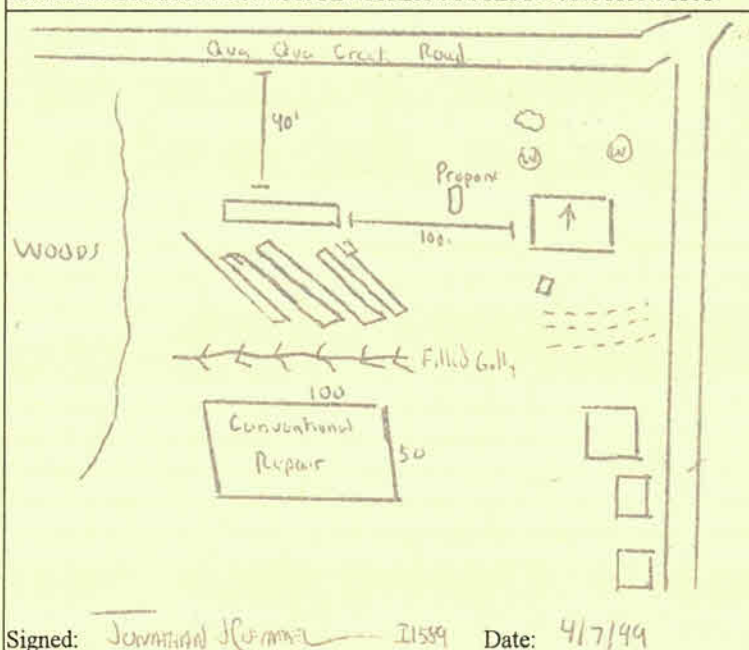

Signed: Jonathan J. Puma 1559 Date: 4/7/99

OPERATION PERMIT

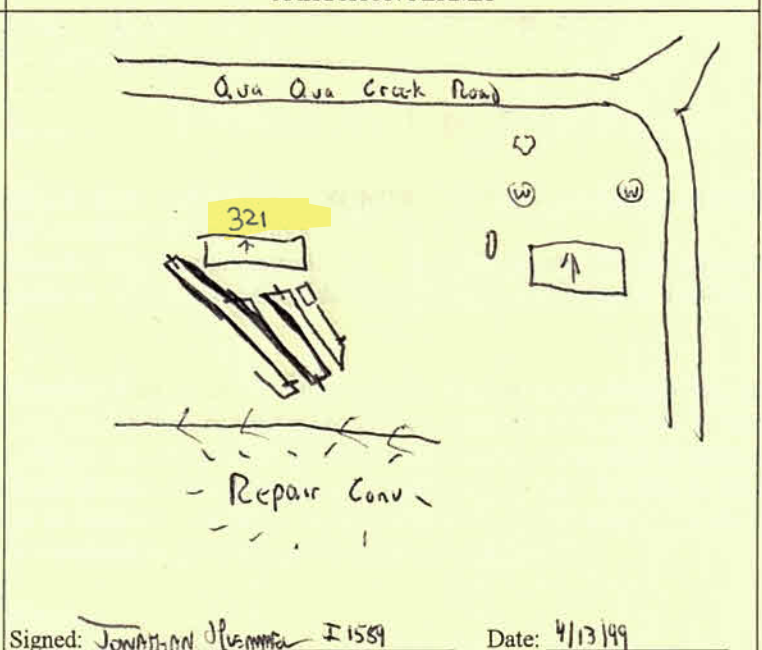

Signed: Jonathan J. Puma 1559 Date: 4/13/99