

ROCKINGHAM COUNTY HEALTH DEPARTMENT

NO. 1071493-2



Improvement permit expires five years from date of issue. Construction is not to begin until all applicable permits have been issued.

☒ Improvement Permit ☐ Authorization
☐ Operation Permit ☒ Cert. of Completion

NAME Wilbur French ADDRESS Route 1, Box 419, Ruffin, NC. 27326
PROPERTY ADDRESS Qua Qua Creek Road - Rt. 1, Box 419, Ruffin
DIRECTIONS TO PROPERTY Estes Road to Qua Qua Creek Road
SUBDIVISION _____ LOT NO. _____ SECTION _____ LOT SIZE 104.98 acres
TAX PIN 8928-00-92-1810 SQUARE FOOTAGE/ACREAGE _____

☒ HOUSE	☒ 3 BEDROOMS	LAYOUT <u>Existing</u>	SPECIFICATIONS <u>new tee</u>	INSTALLED
☐ MOBILE HOME	☒ 3 NO. PERSONS	<u>Existing</u>	TANK SIZE <u>Existing</u>	<u>Existing</u>
☐ BUSINESS	☐ BATH	<u>1,200 sq. ft.</u>	DRAINFIELD SQ. FOOTAGE	<u>1,200 sq. ft.</u>
☐ APT/CONDO	☒ BASEMENT	<u>well</u>	WATER SUPPLY	<u>well</u>
☐ OTHER	☒ BASEMENT	<u>1 (4 segments)</u>	NO. OF LINES	<u>1 (4 segments)</u>
	w/ PLUMBING	<u>400 (20' 20' 20' 20')</u>	TOTAL LENGTH OF LINES	<u>400' (120' 110' 100' 70')</u>
TYPE SYSTEM <u>shallow</u>		<u>18" - 24"</u>	TRENCH DEPTH	<u>shallow 18" - 24"</u>
☐ NEW	A. ☒ CONVENTIONAL	<u>36"</u>	TRENCH WIDTH	<u>36"</u>
☒ REPAIR	B. ☐ L.P.P.	<u>6"</u>	DEPTH OF ROCK UNDER PIPE	<u>6"</u>
	C. ☐ SAND FILTER	<u>12"</u>	TOTAL ROCK DEPTH	<u>12"</u>
INSTALLER	D. ☐ PIT PRIVY	<u>60'</u>	DISTANCE TO FOUNDATION	<u>60'</u>
<u>Billingsley</u>	E. ☐ OTHER (SPEC)	<u>210'</u>	DISTANCE TO PROPERTY LINES	<u>210'</u>
		<u>100'</u>	DISTANCE TO WELL	<u>100'</u>
		<u>county</u>	ZONING JURISDICTION	<u>county</u>
		<u>No</u>	WATER SHED	<u>No</u>
SOLID WASTE DISPOSAL METHOD				

NOTES ON LAYOUT (DESCRIPTION) on contour. Landscape promptly to prevent erosion. Pump out tank and check tank and tee.
THIS PERMIT IS SUBJECT TO REVOCATION IF THE SITE PLANS OR THE INTENDED USE CHANGES.
75 ft. of sched. 40 to drainfield

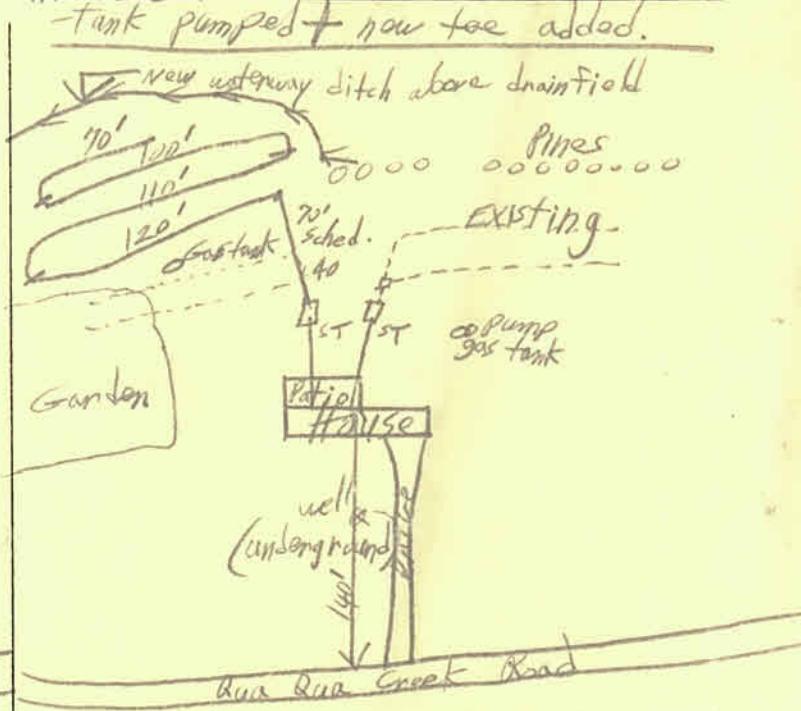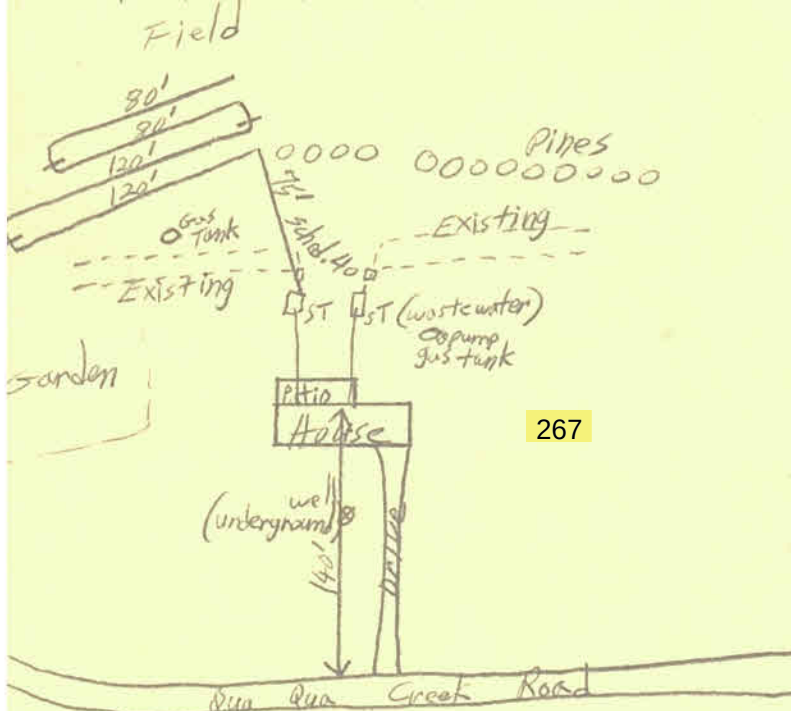

267

IMPROVEMENT PERMIT BY:

L.F. Nelson, Jr. July 14, 1993
TITLE _____ DATE _____

CERTIFICATE OF COMPLETION BY:

L.F. Nelson, Jr. Aug. 3, 1993
TITLE _____ DATE _____

APPEALS: By written petition to the Office of Administrative Hearings, P.O. Drawer 27447, Raleigh, North Carolina 27611-7447. In accordance with GS.1508-23(a).

This permit may be suspended or revoked upon a finding that a violation of...this Chapter, The Rules...or a condition imposed upon the permit has occurred...Also upon a finding that its issuance was based on incorrect or inadequate information. GS.1508-23(a)(1)(d)