

# BELL COUNTY HEALTH DEPARTMENT

Permit No.

Temple, Belton, Killeen

N<sup>o</sup> B 147

## PERMIT TO INSTALL A SEPTIC TANK SYSTEM

Location Bottoms Road St. Address 4022 Berger Rd Blk. 1 Lot 1 Sec. 1 B 1  
 Legal Description: Survey Christopher Adams 112ac. Abstract No. 48 Vol. 150 Page 251  
 Flood Plain Exempt 558 Application Taken By S. Garner Date 1-7-87  
 Owner Wm E. Covington Address Rt. 1 Box 211 m Temple Phone 938-7439  
 Installer Andy Mutter & Sons Address Box 1576 Lett, TX Phone 766-5656  
 Signature X. William E. Covington Amount Paid 50 cash (home)  
 No. of Bedrooms 2 Size of Septic Tank Required: 750 gal.; Size Installed: 1000 gal.  
 Soil Type ASC Disposal Fields: Total Area Req. 5.00 Sq. Ft.; Total Area Installed 710 Sq. Ft.

\*If soil type varies from that stated reflecting an increased percolation rate, size of disposal fields must be increased accordingly.

Width of Trench 2 ft. Length of Trench 355 ft. Depth of Trench 1 1/2 ft.


- I. Tank Size: 1 or 2 BR. — 750 gal.; 3 BR. — 1000 gal.; 4 BR. — 1250 gal.; 5 BR. — 1500 gal.
- II. Tank from House — 5 ft.; property line — 10 ft.
- III. Disposal Field from house — 15 ft.; property line — 10 ft.; water lines — 10 ft.; Distance between lines — 5 ft.
- IV. Bottom of absorption ditches and drainfield should be essentially level, drop not to exceed one inch per 100 ft.
- V. I certify that this system is installed in accordance with Sanitary Regulation I., Bell County, Texas.

X Wayne Jewell  
 Installer

Remarks: \_\_\_\_\_

Date 3-5-87 Does System meet minimum Department Standards Yes ✓ No \_\_\_\_\_  
Maria J. Willhite, R.S.  
 Inspector

Drawing of System: (Not to scale)

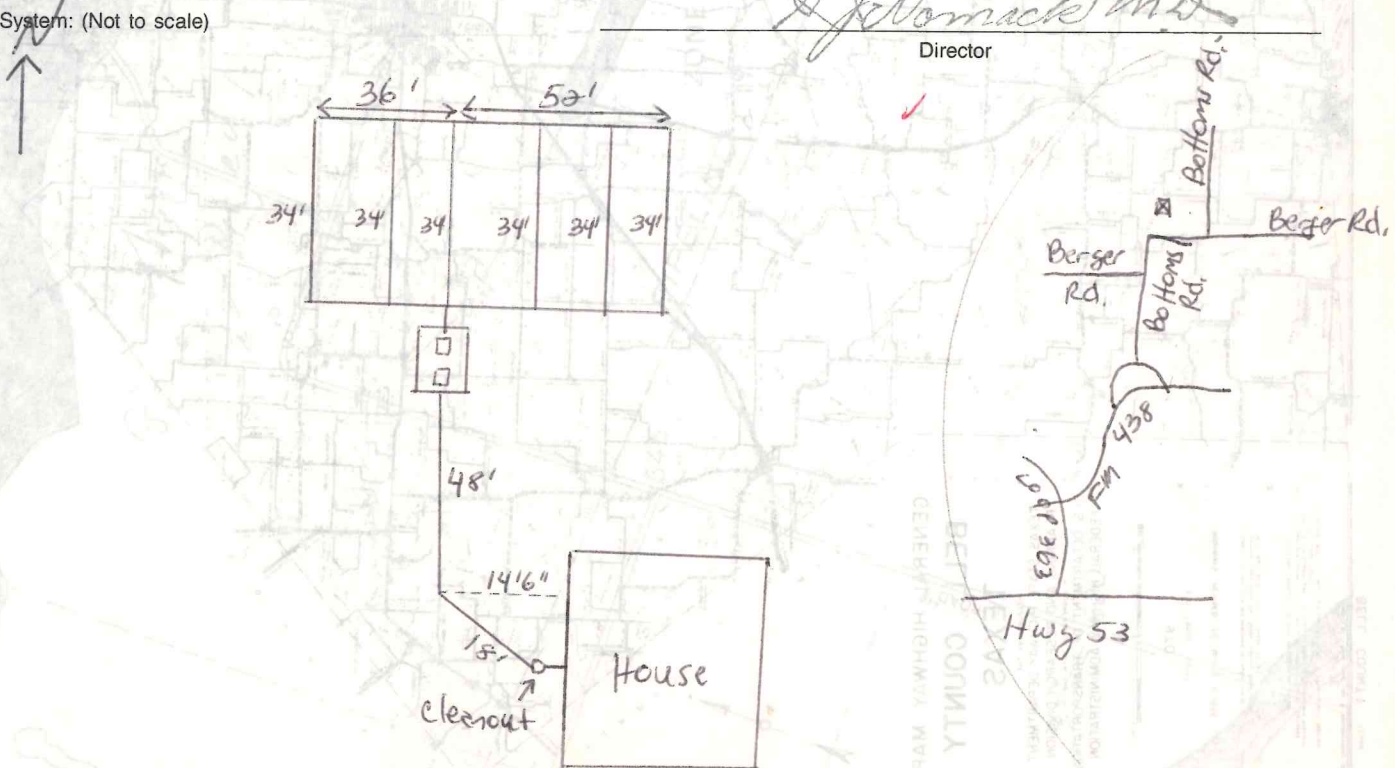

Director