



PERMIT TO CONSTRUCT
Onsite Wastewater System

File Nbr **2019030021**
County: Colleton

Name: MR JONATHAN COMPTON

Type Facility: HOUSE

Subdivision:

Block:

Lot: 1 OF 3

Address: 7337 HIGHWAY 165
RAVENELL, SC 29470

Site: RED OAK RD

COTTAGEVILLE, SC 29488

Program Code: 362

System Code: 270

TM#: 120-00-00-020.000

Water Supply: PRIVATE

PERMIT TO CONSTRUCT SYSTEM SPECIFICATIONS

Daily Flow (gpd): 360

LTAR: .70

Tank Sizes (gal): Septic Tank: 1000

Pump Chamber:

Grease Trap:

Trenches: Length (ft): 102 Width (in): 108 Max. Depth (in): 13

Agg. Depth (in): 6

Min Pump Capacity: gpm at

ft. of Head

SPECIAL INSTRUCTIONS/CONDITIONS


THIS PERMIT IS SITE SPECIFIC. ANY CHANGES TO THE SYSTEM MUST BE APPROVED BY DHEC. ALTERNATIVE TRENCH PRODUCTS APPROVED UNDER STATE RULES AND REGULATIONS MAY BE SUBSTITUTED. ANY UNAPPROVED CHANGES WILL VOID THIS PERMIT.

- All applicable setbacks set forth in Regulation 61-56 apply.
- Maximum Trench Depth not to exceed 13 inches
- Do not cut, fill, bulldoze, scrape or change the grade of the natural soils in the septic system area.
- Do not install under wet soil conditions. Minimum 75' from private well; 100' from public well.
- No parking, driving, building or paving over the area of septic system before or after installation.
- Minimum 12" cover over system after installation with 5' buffers and 10' tapers from outside edges of trenches.
- Preconstruction conference required for property owners who wish to install their own system.

PERMIT TO CONSTRUCT SYSTEM DIAGRAM

(NTS)

Part of 141.0 Acres

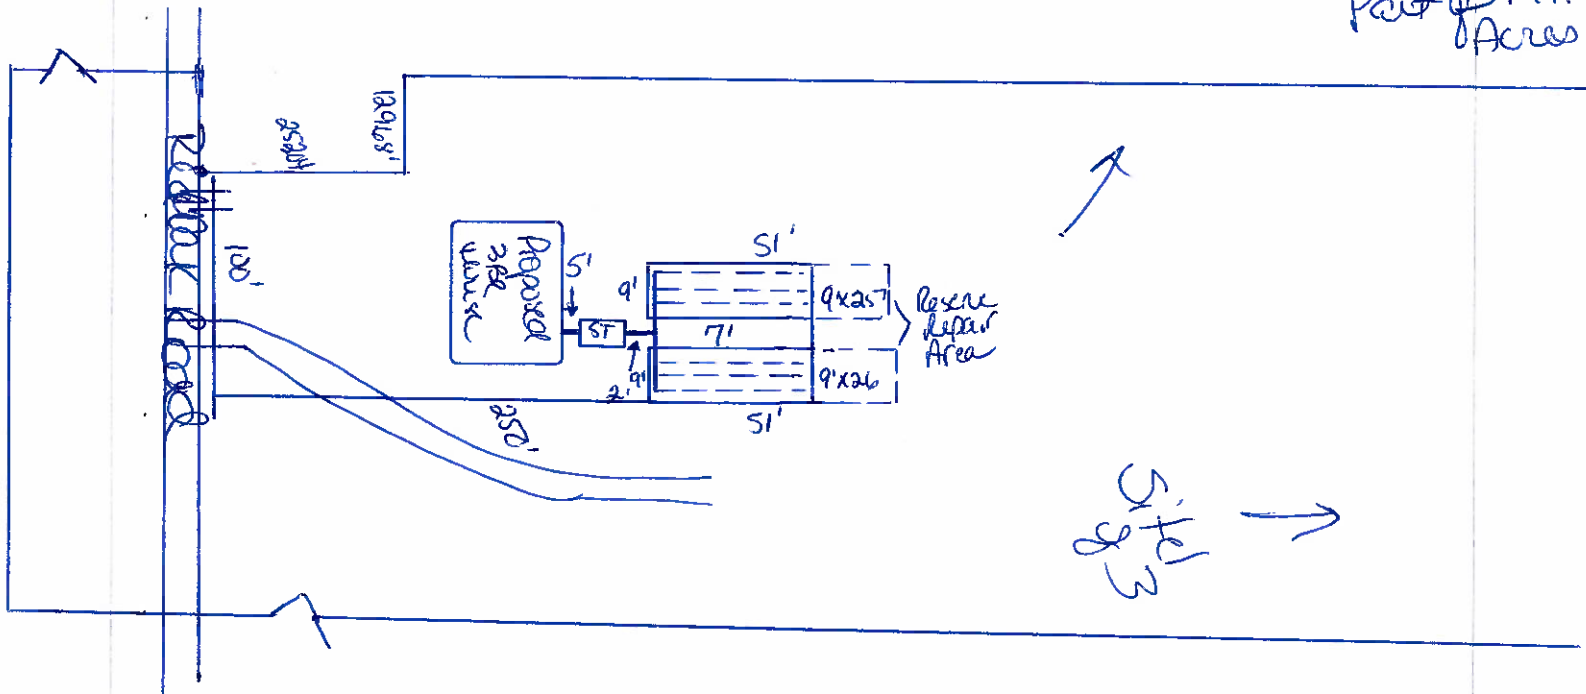

Issued/Revised By: Kmisa

Date: 4/15/19

DHEC 1781 (01/2014)

This Permit is Appealable Under the Administrative Procedures Act.
There may be an Additional Fee for Changes in this Permit that Require a Site Reevaluation.