

WV STATE DEPARTMENT OF HEALTH
Office of Environmental Health Services
ENVIRONMENTAL ENGINEERING DIVISION

SW258

WELL COMPLETION REPORT

Date(s) July 6 1993 County Hampshire Permit #: DW14-06-93-292
Town: Capon Bridge Area Name/Location Timber Mountain Subdivision Lot 1
Well Owner: Tommy & Cheryl Crown Address: 3210 Kimberly Dr.
Telephone Number: 410 635-2367 MT Airy, MD 21771
Well Driller: Serry W Adams Address: PO Box 952
Telephone Number: 364 822-4092 Romney, WV 26757

WELL LOG

DEPTH IN FEET	FORMATIONS: KIND, THICKNESS, AND IF WATER BEARING	REMARKS:
0-28'	SAND & CLAY - UNCONSOLIDATED	Type of Well: <u>D/W</u> Drilling Method: <u>Air Rotary Hammer</u>
29'	Gray Shale - UNCONSOLIDATED	Well Diameter: <u>6-1/8"</u> Casing O.D.: <u>6-5/8"</u>
41'	Gray Shale - Consolidated	Well Depth: <u>300'</u> Date Completed: <u>7-6-93</u>
	Set Casing - GROUT	CASING: Length <u>42</u> Feet Height above ground _____ Feet
82'	Gray Shale - Consolidated	☒ Steel ☐ Plastic ☐ Cast Iron
120'	Gray Shale - Consolidated	Other _____ Type _____
180'	Gray Shale - Consolidated	
243'	limestone - WATER 1-1/2 GPM	SCREEN
258'	Red Shale - Consolidated	☒ None Installed
279'	limestone - Consolidated	Type _____ Diameter _____
	Water 2-1/2 GPM	Slot/Gauge _____ Length _____
300'	limestone - Consolidated	Set Between _____ Ft. and _____ Ft.
	Test well yield - Stopped	
	Drilling Operation	

PUMPING OR BAILING TEST

DETAILS	#1	#2	#3
Static Water Level (Ft. Below Grade)	<u>195'</u>		
Pumping Rate (GPM)	<u>4</u>		
Pumping Level (Ft Below Grade)	<u>290'</u>		
Duration of Test (In Hours)	<u>1</u>		
Recovery Time to Static Level (In Hours)	<u>2-1/2</u>		

WELL HEAD

Pitless Adapter: Type, Make, Etc. To be installed w/ Pump Syst
Well Cap: Type, Make, Etc. Royer 6-5/8" Conduit Type
Well Seal: Type, Make, Etc. _____
Well Platform: _____
Length _____ Width _____ Thickness _____
Grouting: ☒ Yes ☐ No
All Public Water Supplies must be grouted.

I hereby certify that this well was drilled and constructed under my supervision, in compliance with all requirements of the referenced permit, and that this record is true to the best of my knowledge and belief.

Serry W Adams 004
Name A & S Well Drilling Certification No.
Registered Business Name Serry W. Adams July 6, 93
Signed _____ Date

SS-177
Revised 1-71

WEST VIRGINIA
SEPTIC TANK INSPECTION FORM

Hamshire County Health Department Installation Permit No. ST-14-94-30
Name of Owner Tommy Crown
Address 3210 Kimberly Drive, Mt. Airy, MO 21771
Property Address Timber Mtn. Sub. Lot #7

DESCRIPTION & NUMBER OF UNITS SERVED

Type Facility Served house-to-be No. Water Closets
Lot Size 2+ acres sq. ft. Area suitable for sewage disposal installation sq. ft.
Source of Water Supply well No. Lavatories
No. Bedrooms 2 No. Showers or Tubs No. Baths
No. Garbage Grinders No. Automatic Washers

SEPTIC TANK

Material precast Length x Width x Depth = cubic feet
Liquid Depth ft. Liquid Capacity 1000 gal.
Distance to: Dwelling 29' Water Supply 82' Nearest Property Line 100' +

SOIL ABSORPTION SYSTEM

Type Drain Line Material gravelless Trench Width 24 Inches
Trench Depth 24 Inches Total Absorption area in Trench Bottom 600 sq. ft.
Diameter of Drain Line 10 Inches Type Filter Media
No. of Drain Lines 2 Depth Filter Media Under Drain Line Inches
Length of Each Line 100, 100, , ft. Depth Filter Media Over Drain Line in.
Distance of Disposal Field to: (a) Dwelling 52'
(b) Water Supply 114' (c) Nearest Property Line 100' +

An inspection of the septic tank system described herein disclosed that said system (MEETS, DOES NOT MEET) the minimum standards established by the West Virginia State Department of Health.

8-10-93
Date


David Dungey
Sanitarian

SKETCH OF SYSTEM TO BE DRAWN ON BACK

Note: Copy of this inspection report must be given to owner and the original filed in the Health Department files. PERMANENT RECORD - DO NOT DESTROY.

Tommy Crown
(Mt. Airy, MD)

* CAPON Bridge
* Timber Mountain
* St-14-94-30

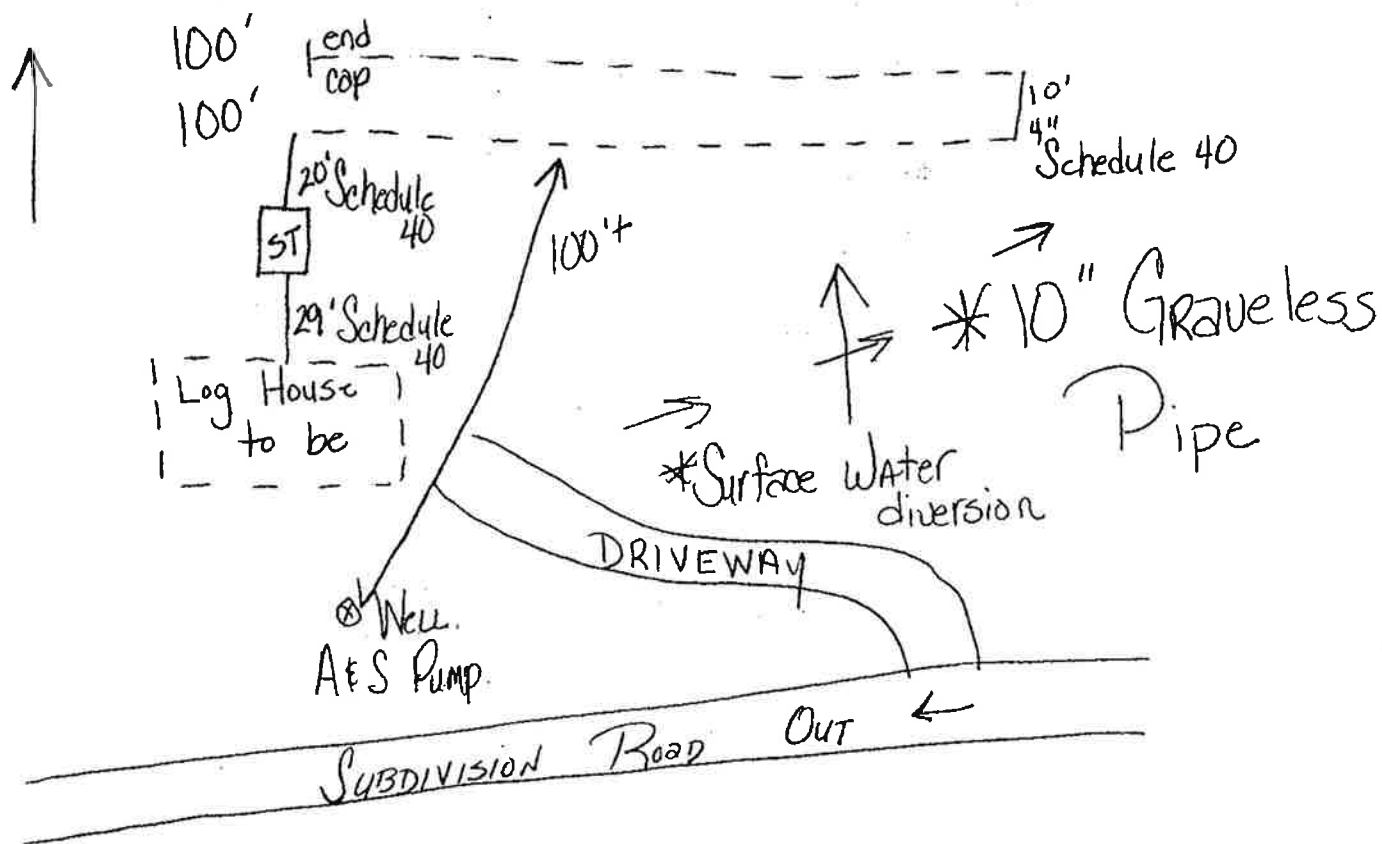

* All LINES LEVEL to Two (2) inches

* 10" GRAVELESS Pipe Used.

* System Installed August 5, 1993.

Installer
Calvin B. Davis
54-83-124