

Apr 10 08 03:39p

Carl R. Reicher

5129132375

p.3

DS
[Signature]

DS
[Signature]

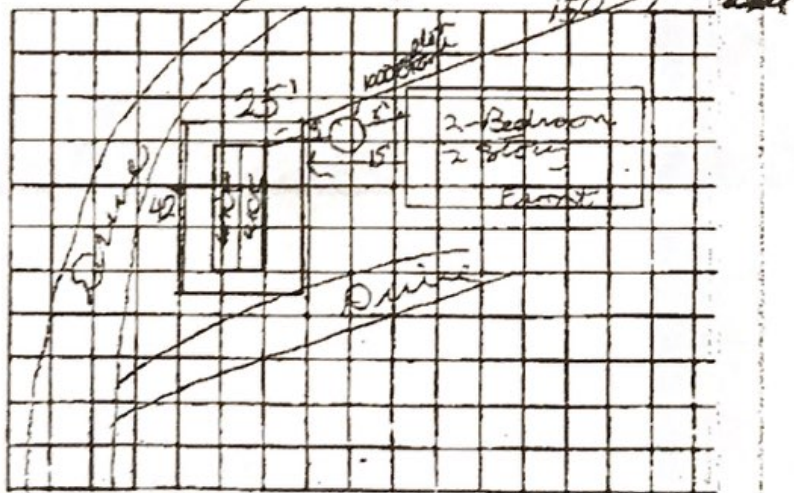
AUSTIN TRAVIS COUNTY HEALTH DEPARTMENT
WASTEWATER DISPOSAL RECORD

Receipt # 132215

Address 15214 Taubman-Lander
Lot 35A Block _____ Sub. Round Mountain Oaks
Owner Nancy Conklin
Installer Smothery Simonson
Engineer _____

Type of dwelling Wood frame Bedrooms 2Percolation test: Date _____ Depth 30Soil Type top soil - no rock

Fall in inches/30 minutes

#1 2" #2 3" #3 _____ #4 _____Tank Capacity 1000 Material concreteLength of Field 42' Width 25'Effective Area 1050 sq. ft. Gravel Depth 12"Sand Depth 10" Fill Depth 8-10"Final Date 12-12-83 Signed Gulcer Magnason15214 Taubman Trail