

## STATE OF WEST VIRGINIA

INSPECTION TO BE  
PRINTED OR TYPED

HEALTH DEPARTMENT

Permit No.: ST-4-02-226

Tax Map: 6 Parcel #: 1-2

County/Road: \_\_\_\_\_

County: Wayne ON-SITE SEWAGE DISPOSAL SYSTEM  
INSPECTION FORM

Name of Owner: Donald Sowers Installer: Donald Sowers  
 Address: P.O. Box 129 Blodgett WV  
 Property Location: Monmouth Hill  
 Type of Facility: House Facility is: New ( ) Existing ( ) Lot Size: 1.579 Sq.-Ft./Acres  
 Design Loading in gpd/No. Bedrooms: 4 BR Source of Water Supply: well

## SEWAGE TANK COMPONENT

Capacity in Gallons: 1000 Material: concrete Manufacturer: S&D  
 Distances (in feet) of Tank to: Dwelling: 16 Private ( ) / Public ( ) Water Source: 125 Property Line: 10+

## ON-SITE DISPOSAL SYSTEM

Class I Systems: Standard Soil Absorption Trenches ( ) or Bed ( ) Gravelless Pipe ( ), Diameter: \_\_\_\_\_ Inches  
 Chamber Soil Absorption Trenches ( ) or Bed ( )  
 Class II Systems: Pumped/Dosed Soil Absorption Trenches ( ) or Bed ( ) Evapotranspiration Trenches ( ) or Bed ( )  
 Shallow Soil Absorption Trenches ( ) or Bed ( ) Other: \_\_\_\_\_

No. of Lines: 4 Length (in feet) of Each: 78, 78, 84, 84  
 Width of Trenches: 36 inches/feet Depth to Bottom of Field: 76 inches  
 If Bed, Dimensions (in Feet): \_\_\_\_\_ If Chamber System, Name: submersible, No. of Units: 20  
 Approved and Adequate Materials Used? Yes ( ) No ( ) Size Equates to: 200 Square Feet of Standard Gravel Field.  
 Distances (in feet) of System to: Dwelling: 40 Private ( ) / Public ( ) Water Source: 110 Property Line: 10+

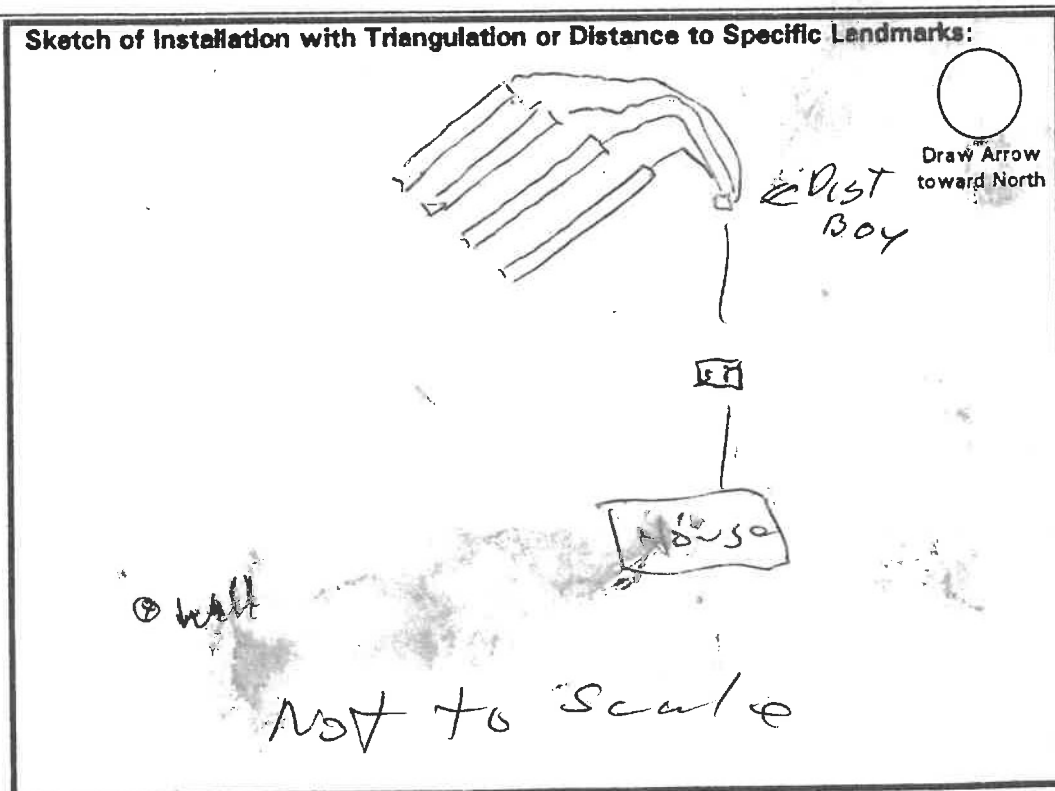
Remarks: \_\_\_\_\_

An inspection indicates that the sewage disposal system described above  
**DOES MEET (X)**  
**DOES NOT MEET ( )**  
**CANNOT BE DETERMINED TO MEET ( )** the minimum standards established by the West Virginia Bureau of Public Health.

To correct a health hazard, modifications to existing systems may be done to improve part of a system. Such modifications may not be able to be designated as a does meet system since inadequate information is known.

Although many factors contribute to the successful functioning of a sewage disposal system, this office recommends water conservation and maintaining an even usage of water throughout the week.

## Sketch of Installation with Triangulation or Distance to Specific Landmarks:

Visit Date(s): 2-13-01Final Inspection Date: 9-26-02Sanitarian: J. K. [Signature]

WV Department of Health and Human Resources  
Bureau of Public Health  
Office of Environmental Health Services  
ENVIRONMENTAL ENGINEERING DIVISION

SW258  
10/01

*Per. 5.8.02*

WELL COMPLETION REPORT

Date(s) 5-01-02 County Hampshire Permit #: DW-14-01-123

Town: slanesville Area Name/Location Monument Hill Sub. Lot 1

Well Owner: Donald G. Sowers

Address: P. O. Box 179

Telephone Number: 304-856-3652

Bloomery, WV 26817

Well Driller: Christopher Wolford

Address: P. O. Box 952

Telephone Number: 822-4092

Romney, WV 26757

WELL LOG

DEPTH IN FEET	FORMATIONS: KIND, THICKNESS, AND IF WATER BEARING	REMARKS: <u>Pressure Grouted</u>
0-5	Red Dirt	Type of Well: <u>D/W</u> Drilling Method: <u>Air Percussion</u>
5-14	Red Shale	Well Diameter: <u>6 1/4"</u> Casing O.D.: <u>6 5/8"</u>
14-23	Red sandstone	Well Depth: <u>290</u> Date Completed: <u>4-30-02</u>
23-29	Lt. blue Sandstone	CASING: Length <u>40</u> Feet Height above ground <u>1</u> Feet
29-30	Dk. Brown Sandstone	<input checked="" type="checkbox"/> Steel <input type="checkbox"/> Plastic <input type="checkbox"/> Cast Iron
30-50	Lt. blue Sandstone	Other _____ Type _____
50-90	Lt. Red sandstone	SCREEN
90-200	Lt. blue Sandstone	<input checked="" type="checkbox"/> None Installed
200-240	Red Sandstone	Type _____ Diameter _____
240-252	Lt. Blue Sandstone	Slot/Gauge _____ Length _____
252-268	Red Sandstone	Set Between _____ Ft. and _____ Ft.
268-290	Lt. Blue Sandstone	

PUMPING OR BAILING TEST

DETAILS	#1	#2	#3
Static Water Level (Ft. Below Grade)	40		
Pumping Rate (GPM)	100+		
Pumping Level (Ft. Below Grade)	275		
Duration of Test (In Hours)	2		
Recovery Time to Static Level (In Hours)	1		

WELL HEAD

Pitless Adapter: Type, Make, Etc. \_\_\_\_\_

Well Cap: Type, Make, Etc. \_\_\_\_\_

Well Seal: Type, Make, Etc. \_\_\_\_\_

Well Platform:

Length \_\_\_\_\_ Width \_\_\_\_\_ Thickness \_\_\_\_\_

Pressure Grouting: ☒ Yes ☐ No

All Public Water Supplies must be grouted.

I hereby certify that this well was drilled and constructed under my supervision, in compliance with all requirements of the referenced permit, and that this record is true to the best of my knowledge and belief.

Christopher Wolford 574  
Name Miller Bros. Drilling Certification No.  
Registered Business Name *Chris Wolford* 5-01-02  
Signed Date