

Site Plan & Well Permit Only

YADKIN COUNTY ENVIRONMENTAL HEALTH

☐ SEPTIC TANK SYSTEM LAYOUT/DESIGN

☒ WELL LOCATION

PERMIT # _____ NAME Teddy Church DATE 8/23/04


04120102996

STS SPECS

NEW INSTALLATION _____	REPAIR _____	LTAR _____
SYSTEM TYPE _____	CLASS _____	REPAIR TYPE _____
SEPTIC TANK _____	(gal) LINEAR FT _____	TRENCH DEPTH _____
PUMP TANK _____	(gal) STONE DEPTH _____	COVER DEPTH _____
INSTALLER: _____	NO. BOXES _____	NO. LINES _____

WELL INFO

☒ NEW WELL ☐ REPLACEMENT WELL ☒ WELL FOR SINGLE RESIDENCE
☐ WELL FOR 2 OR MORE RESIDENCES ☒ PRIVATE WELL ☐ PUBLIC WELL

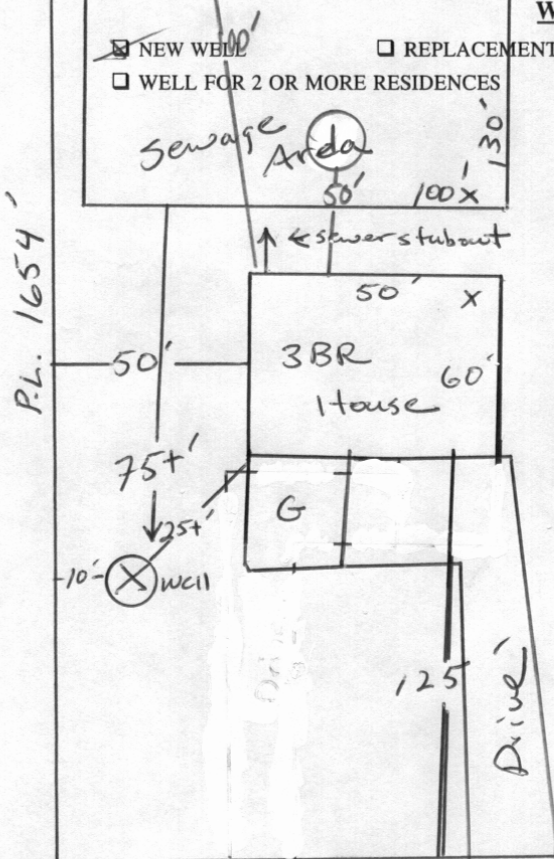

Lone Hickory Rd.

COMMENTS: _____

BY: Chuck Wenzel EHS/RS

YADKIN COUNTY ENVIRONMENTAL HEALTH

☒ SEPTIC TANK SYSTEM LAYOUT/DESIGN ☐ WELL LOCATION

PERMIT # _____ NAME Teddy Church DATE 3-7-05


0412 0102996

STS SPECS

NEW INSTALLATION	REPAIR	LTAR	.35
SYSTEM TYPE <u>conv.</u>	CLASS <u>II</u>	REPAIR TYPE <u>Conv.</u>	CLASS <u>II</u>
SEPTIC TANK <u>1000</u>	(gal) LINEAR FT <u>335'</u>	TRENCH DEPTH <u>36"</u>	
PUMP TANK	(gal) STONE DEPTH <u>12"</u>	COVER DEPTH <u>24"</u>	
INSTALLER: <u>Lakey Backhoe</u>	NO. BOXES <u>4</u>	NO. LINES <u>4</u>	

WELL INFO

- ☐ NEW WELL ☐ REPLACEMENT WELL ☐ WELL FOR SINGLE RESIDENCE
☐ WELL FOR 2 OR MORE RESIDENCES ☐ PRIVATE WELL ☐ PUBLIC WELL

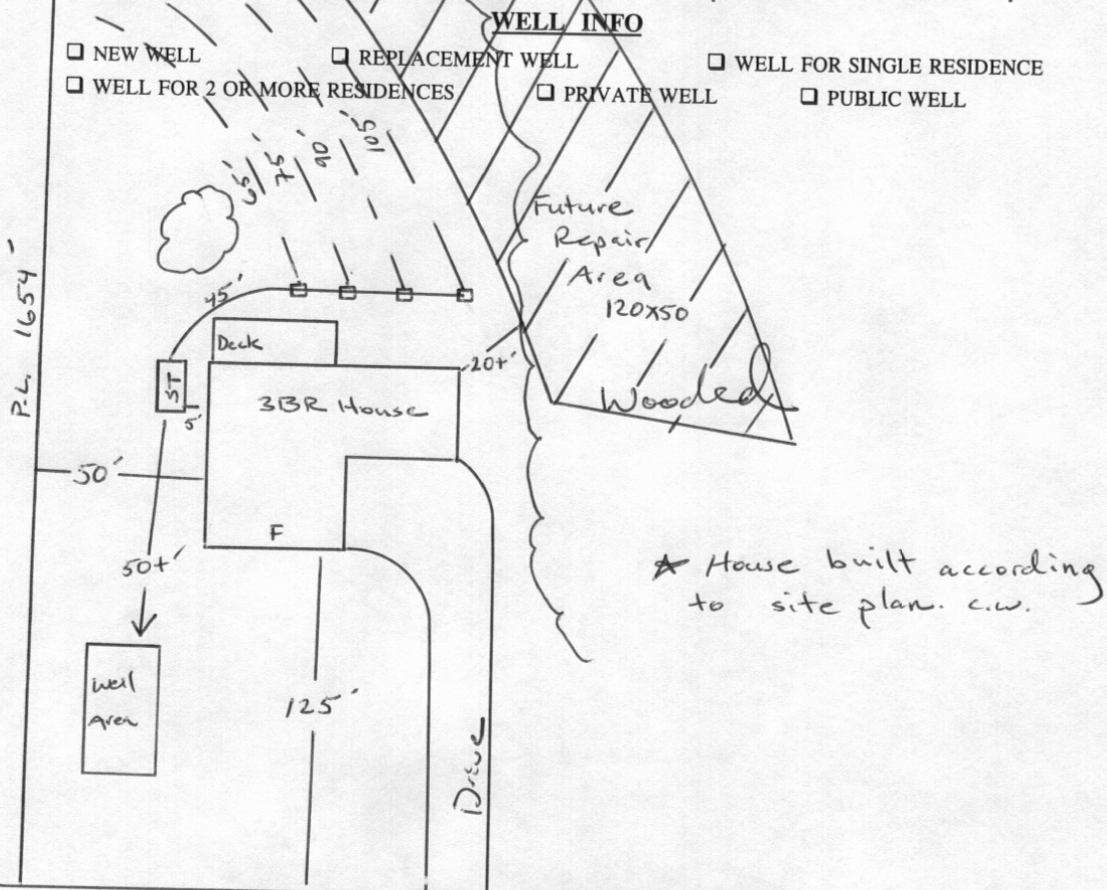

Lone Hickory Rd. W →

COMMENTS: _____

BY: Chuck Wood EHS/RS

