

STATE OF WEST VIRGINIA

INSPECTION TO BE
PRINTED OR TYPED

HEALTH DEPARTMENT

Permit No.: ST-14-02-310ON-SITE SEWAGE DISPOSAL SYSTEM
INSPECTION FORMTax Map: 31 Parcel #: 133

County Road: _____

County: Wangover

Name of Owner: BLACKTHORN PARTNERSHIP Installer: Randal Miller
 Address: P.O. Box 952 Romney WV 26252
 Property Location: BLACKTHORN RIDGE ESTATES LOT #13
 Type of Facility: House Facility is: New (☒) Existing () Lot Size: 4 Sq. Ft./Acres
 Design Loading in gpd/No. Bedrooms: 3 BR Source of Water Supply: well

SEWAGE TANK COMPONENT

Capacity in Gallons: 1000 Material: concrete Manufacturer: J. I. Co.
 Distance (in feet) of Tank to: Dwelling: 46 Private (☒) Public () Water Source: 140 Property Line: 10+

ON-SITE DISPOSAL SYSTEM

Class I Systems: Standard Soil Absorption Trenches () or Bed () Gravelless Pipe (), Diameter: _____ Inches
 Chamber Soil Absorption Trenches (☒) or Bed ()
 Class II Systems: Pumped/Dosed Soil Absorption Trenches () or Bed () Evapotranspiration Trenches () or Bed ()
 Shallow Soil Absorption Trenches () or Bed () Other: _____

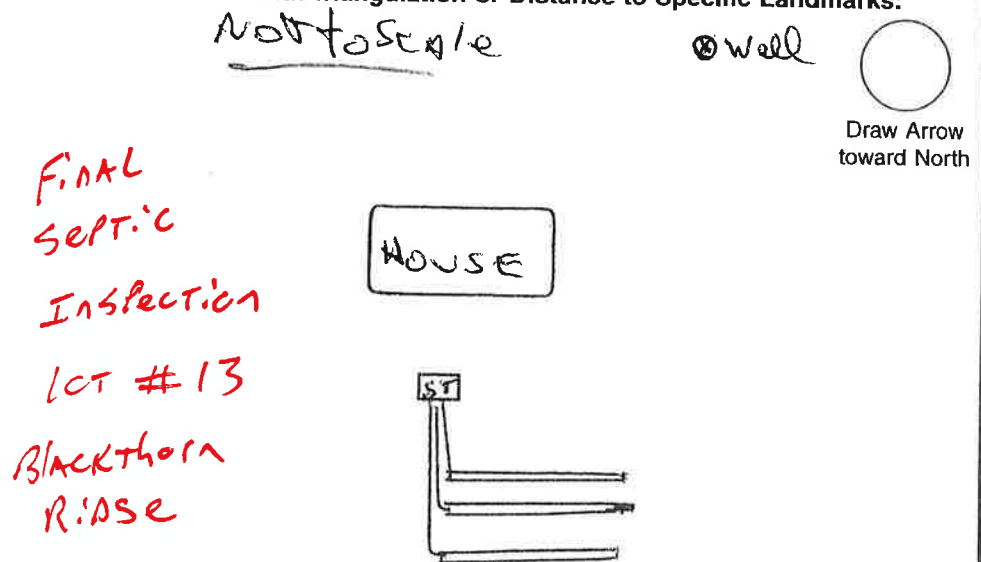
No of Lines: 3 Length (in feet) of Each: 80, 73, 80
 Width of Trenches: 36 inches/feet Depth to Bottom of Field: 24-36 inches
 If Bed, Dimensions (in Feet): _____ If Chamber System, Name: Inst. 14-02-310 No. of Units: 39
 Approved and Adequate Materials Used? Yes (☒) No () Size Equates to 200 Square Feet of Standard Gravel Field.
 Distance (in feet) of System to: Dwelling: 85 Private (☒) Public () Water Source: 200 Property Line: 10+
 Remarks: _____

An inspection indicates that the sewage disposal system described above
DOES MEET (x),
DOES NOT MEET (),
CANNOT BE DETERMINED TO MEET () the minimum standards established by the West Virginia Bureau of Public Health.

To correct a health hazard, modifications to existing systems may be done to improve part of a system. Such modifications may not be able to be designated as a **does meet** system since inadequate information is known.

Although many factors contribute to the successful functioning of a sewage disposal system, this office recommends water conservation and maintaining an even usage of water throughout the week.

Sketch of Installation with Triangulation or Distance to Specific Landmarks:

Visit Date(s) 4-8-02Final Inspection Date: 1-9-04Sanitarian: J. K. K.

WEST VIRGINIA BUREAU FOR PUBLIC HEALTH



PERMIT



OWNER: Randall & Jeffrey Miller and DRILLER Miller Brothers Drilling

are hereby issued a permit to Construct a well located
(Construct, Modify or Abandon)

at Rt. 50 east to 29N., 1 mile. Subdivision on left. Enter subdivision, go
100 feet, bare right, follow to top of hill, left on Denney Drive to
in accordance with Chapter 16, Article 1, Section 9 of the Code of West Virginia. Culdasac

Date issued 7-22-03

Expires 7-22-04

Permit No. DW-14-04-10

Black Ridge Estates Lot #13
[Signature] Sanitarian
Issuing Officer
Locate for Subdivision Plat
Hampshire
County Health Department

This permit is not transferable and any change of information submitted in application dated 7-18-03 will automatically render this permit invalid.

THIS PERMIT IS NOT APPLICABLE TO PUBLIC WATER SUPPLIES

Well Permit

LOT 13

Blackthorn Ridge

Hampshire County Health Department
HC 71, Box 9
Augusta, WV 26704
(304) 496-9640 Fax: (304) 496-9650

Perk
APPROVAL
C
1.75 AC
LCT

March 4, 2008

Hampshire County Planning Commission
P. O. Box 883
Romney, WV 26757

Dear Sirs;

This office has reviewed a plat of survey for Carol McKee to approve a lot located on Route 29, and further referenced as Gore District, Tax Map 31, Parcel 29, Deed book 463, Page 469. This lot consists of 1.75 acres. All lots require a percolation test and a sewage disposal area of 10,000 square feet where no development or structures other than the septic system shall be permitted. This lot is to be developed with an individual well and septic system to serve a single family dwelling.

Percolation test results are within limits as set forth by West Virginia CSR 16-1. Six foot soil observation holes indicate no restrictions due to water table or shallow bedrock within the designated sewage disposal area **except as noted on the Health Department subdivision application.**

The plat of survey dated October 20, 2007 is hereby approved by the Hampshire County Health Department for a Class I sewage system. Any changes or revisions to the Health Department stamped and signed plat, or subsequent final plats approved based upon the approved plat, will make this approval null and void.

This approval is not a permit for individual water systems or individual sewer systems. Applications for permits must be made separately to the Hampshire County Health Department.

Sincerely,
Jim Kinder R.S.



cc: Carol McKee