

YADKIN COUNTY HEALTH DEPARTMENT

(Septic Tank) Improvements Permit and Certificate of Completion

(Ground Absorption Sewage Disposal System - G.S. Chapter 130-Article 13C)

OWNER OR CONTRACTOR Michael Thomsen (H.G.) DATE 3/18/74 PERMIT

LOCATION Farmland Forest - All Old 421 - Pine on No. 138

Right S.R. NO. _____

SUBDIVISION NAME 1 house LOT NO. _____ SECTION OR BLOCK NO. _____

HOUSE ☒ MOBILE HOME ☐ BUSINESS ☐

NO. BEDROOMS 3 NO. BATHROOMS 2

GARBAGE DISPOSAL UNIT YES ☒ NO ☐

AUTO. DISHWASHER YES ☒ NO ☐

AUTO. WASH. MACHINE YES ☒ NO ☐

SITE SUITABLE YES ☒ NO ☐

SIZE OF TANK 900 gal.


NITRIFICATION FIELD 440 sq. ft.

DEPTH OF STONE IN LINES: 12" under pipe, 18" in all

WATER SUPPLY: Individual ☒ Public ☐

IMPROVEMENTS PERMIT BY Steve Brown

LOT AREA 74,000 sq. ft.

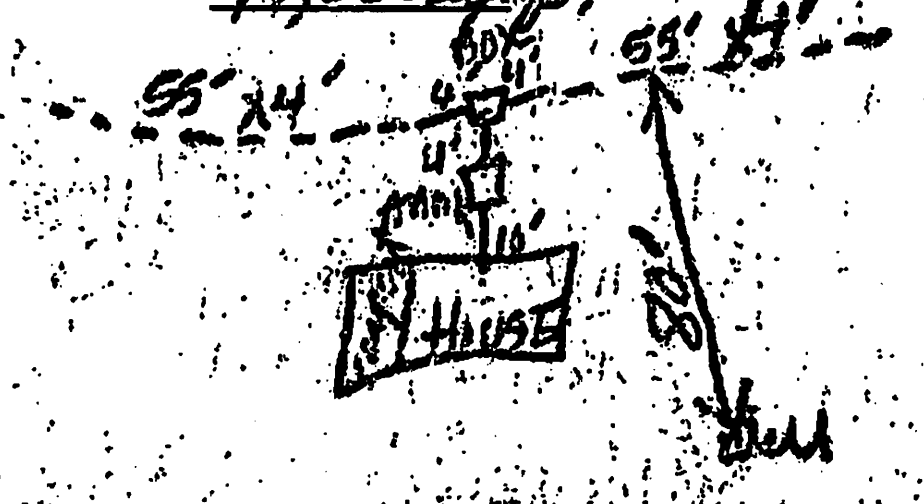

INSTALLED BY Food Salvage

CERTIFICATE OF COMPLETION By Steve Brown Date 3/18/74

(8/16/73) *Construction must comply with all other applicable State and local regulations