


APPLICANT: Maurice Cunsford APPLICANT ADDRESS: 2211 S. Jennings Rd PHONE: 704-437-3461 ALT. PHONE: N/A
SITE ADDRESS: 3460 Jennings Rd STATEVILLE NC
SITE DIRECTIONS: Hwy 901 N/A Jennings Rd 1 mile on left
SUBDIVISION: N/A SECTION: 1/4 LOT # N/A LOT AREA: 27.23 ac DESIGN FLOW: 480 L.T.A.R.: 0.25

Septic Tank	1000 (gal)	STB	854	Date	4-10-78	☒ New System	☐ Repair	☐ Expansion	System Type: I II III IV V VI	☒ Residence	No. Bedrooms	7	☒ Water Supply
Pump Tank		PT		Date		☐ System Description:	☐ Repair	☐ Expansion		☐ Business	No. Persons	8	☐ Private
Pump Make		Model		Serial #		Repair System Description:	☒ 25% Reduction	☐ YES	☒ NO	☐ Other	No. Employees		☒ Public
# Nitritification Fields	1	# Lines	4	Linear Ft.	780	Maintenance Agreement Required:	☐ YES	☒ NO		☐ Slab	☒ Crawl Space		☐ Community
Trench Width	36"	Max. Trench Bottom Depth	24"	Gravel Depth	N/A	☒ GRAVITY	☐ PRESSURE			☐ Basement w/ plumbing	☐ Basement w/o plumbing		

Comments / Conditions: Install 25% reduction on contour with Serial distribution.

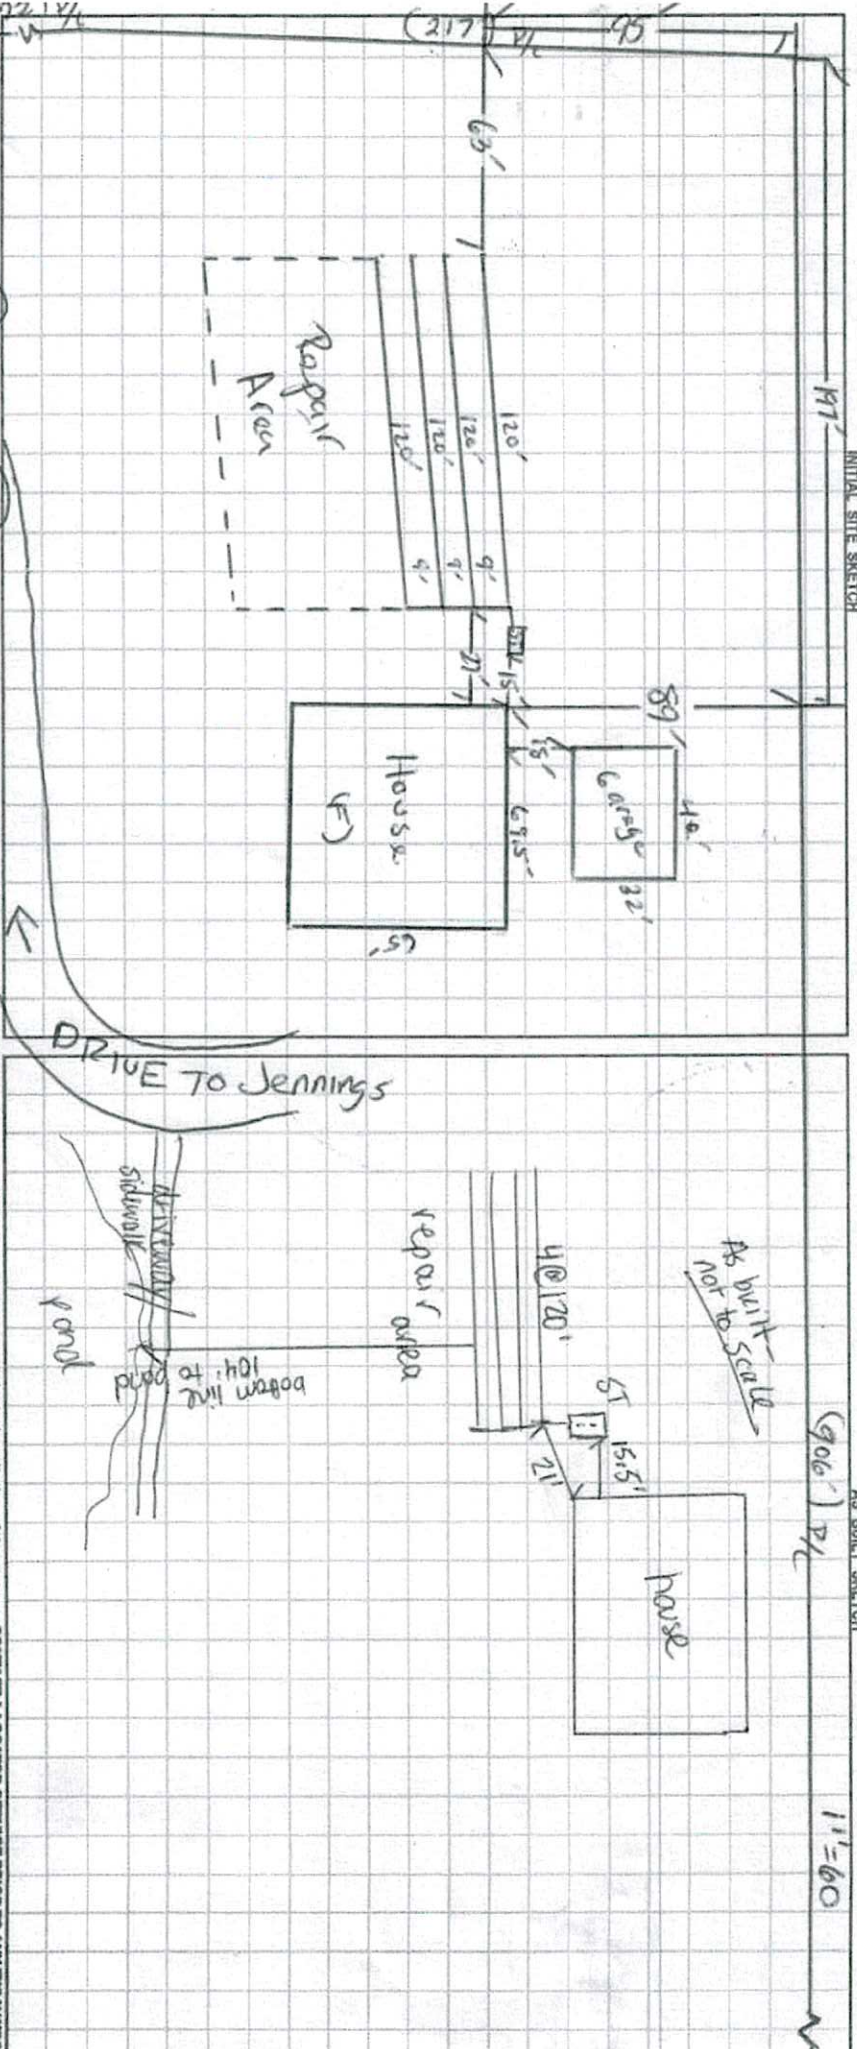

Permit can be suspended or revoked if any false information is supplied toward securing the permit / any unauthorized changes are made to the site / any unauthorized changes are made in the installation of the system. CONTACT A LOCATOR SERVICE PRIOR TO ANY EXCAVATION.
☐ IMPROVEMENT PERMIT with plan valid without inspection. ☒ IMPROVEMENT PERMIT with site plan valid for 60 mos. ☒ AUTHORIZATION TO CONSTRUCT valid for period equal to IMPROVEMENT PERMIT - not to exceed 60 mo.

Owner / Applicant Signature: [Signature] Date: 08/21/15
Improvement Permit by: [Signature] Date: 08/21/15
Authorization to Construct by: [Signature] Date: 08/21/15
Installed by: [Signature] Date: 08/21/15
Operation Permit by: [Signature] Date: 08/21/15
Existing System Inspected by: [Signature] Date: 08/21/15

SOIL/SITE EVALUATION
for ON-SITE WASTEWATER SYSTEM
(Complete all fields in full)

OWNER: Maurice Lunsford APPLICATION DATE 07/27/15
ADDRESS: 3460 Jennings Rd DATE EVALUATED: 10/1/15
PROPOSED FACILITY: SED PROPOSED DESIGN FLOW (.1949): 450 PROPERTY SIZE: 17.23ac
LOCATION OF SITE: 901 to Jennings on left PROPERTY RECORDED: Yes
WATER SUPPLY: ☐ Private ☒ Public ☐ Well ☐ Spring ☐ Other N/A
EVALUATION METHOD: ☐ Auger Boring ☒ Pit ☐ Cut TYPE OF WASTEWATER: ☒ Sewage ☐ Industrial Process ☐ Mixed

P R O F I L E #	.1940 LANDSCAPE POSITION/ SLOPE %	HORIZON DEPTH (IN.)	SOIL MORPHOLOGY (.1941)		OTHER PROFILE FACTORS				PROFILE CLASS & LTAR
			.1941 STRUCTURE/ TEXTURE	.1941 CONSISTENCE/ MINERALOGY	.1942 SOIL WETNESS/ COLOR	.1943 SOIL DEPTH	.1956 SAPRO CLASS	.1944 RESTR HORIZ	
Pit 1	L 7%	0-7	Gr SCL	lv SE	PS	PS	1/4	37"	PS .25
		7-17	SBK C	fi SE					
		17-37	WSBK BC	fi/v SE					
		37-48	Mass GR	fi s w/a					
			Manganese 7'-17"						
Pit 2	L 70%	0-9	Gr SCL	lv SE	PS	PS	1/4	w/a	PS .25
		9-32	ABK C	fi SE					
		32-48	WABK BC	fi/v SE					
			Few manganese deposits 9'-32"						
Pit 3	L 70%	0-9	Gr SCL	lv SE	PS	PS	1/4	w/a	PS .25
		9-25	SBK C	fi SE					
		25-48	WSBK BC	fi/v SE					
Pit 4	L 10%	0-6	Gr SCL	lv SE	PS	PS	41"	41"	PS .25
		6-25	ABK C	fi SE					
		25-41	WSBK BC	fi/v SE					
		41-54	Mass sapst	fi SE					

DESCRIPTION	INITIAL SYSTEM	REPAIR SYSTEM	OTHER FACTORS (.1946): <u>PS</u>
Available Space (.1945)	<u>PS</u>	<u>PS</u>	SITE CLASSIFICATION (.1948): <u>PS</u>
System Type(s)	<u>III</u>	<u>III</u>	EVALUATED BY: <u>H. Snow</u>
Site LTAR	<u>.25</u>	<u>.25</u>	OTHER(S) PRESENT: <u>N/A</u>

COMMENTS:

LEGEND

use the following standard abbreviations

LANDSCAPE POSITION	GROUP	SOIL TEXTURE	CONVENTIONAL 1955 LTAR*	LPP 1957 LTAR*	MINERALOGY/ CONSISTENCE	STRUCTURE
CC (Concave Slope)	I	S (Sand)	1.2 - 0.8	0.6 - 0.4	SEXP (Slightly Expansive) EXP (Expansive)	G (Single Grain)
CV (Convex Slope)		LS (Loamy Sand)				M (Massive)
D (Drainage Way)	II	SL (Sandy Loam)	0.8 - 0.6	0.4 - 0.3		CR (Crumb)
DS (Debris Slump)		L (Loam)				GR (Granular)
FP (Flood Plain)	III	Si (Silt)	0.6 - 0.3	0.3 - 0.15		SBK (Subangular Blocky)
FS (Foot Slope)		SiCL (Silty Clay Loam)				ABK (Angular Blocky)
H (Head Slope)		CL (Clay Loam)				PL (Platy)
L (Linear Slope)		SCL (Sandy Clay Loam)				PR (Prismatic)
N (Nose Slope)		SiL (Silt Loam)				
R (Ridge)	IV	SC (Sandy Clay)	0.4 - 0.1	0.2 - 0.05		
S (Shoulder Slope)		SiC (Silty Clay)				
T (Terrace)		C (Clay)				
		O (Organic)				

MOIST

VFR (Very Friable)
FR (Friable)
FI (Firm)
VFI (Very Firm v. Very Sticky)
EFI (Extremely Firm)

WET

NS (Non-sticky)
SS (Slightly Sticky)
S (Sticky)
VS (Very Sticky)
NP (Non-plastic)
SP (Slightly Plastic)
P (Plastic)
VP (Very Plastic)

*Adjust LTAR due to depth, consistence, structure, soil wetness, landscape, position, wastewater flow and quality.

NOTES

HORIZON DEPTH

DEPTH OF FILL

RESTRICTIVE HORIZON

SAPROLITE

SOIL WETNESS

CLASSIFICATION

Evaluation of saprolite shall be by pits.

Long-term Acceptance Rate (LTAR): gal/day/ft²

In inches below natural soil surface

In inches from land surface


Thickness and depth from land surface

S(suitable) or U(unsuitable)

Inches from land surface to free water or inches from land surface to soil colors with chroma 2 or less - record Munsell color chip designation

S (Suitable), PS (Provisionally Suitable), or U (Unsuitable)

Show profile locations and other site features (dimensions, reference or benchmark, and North).

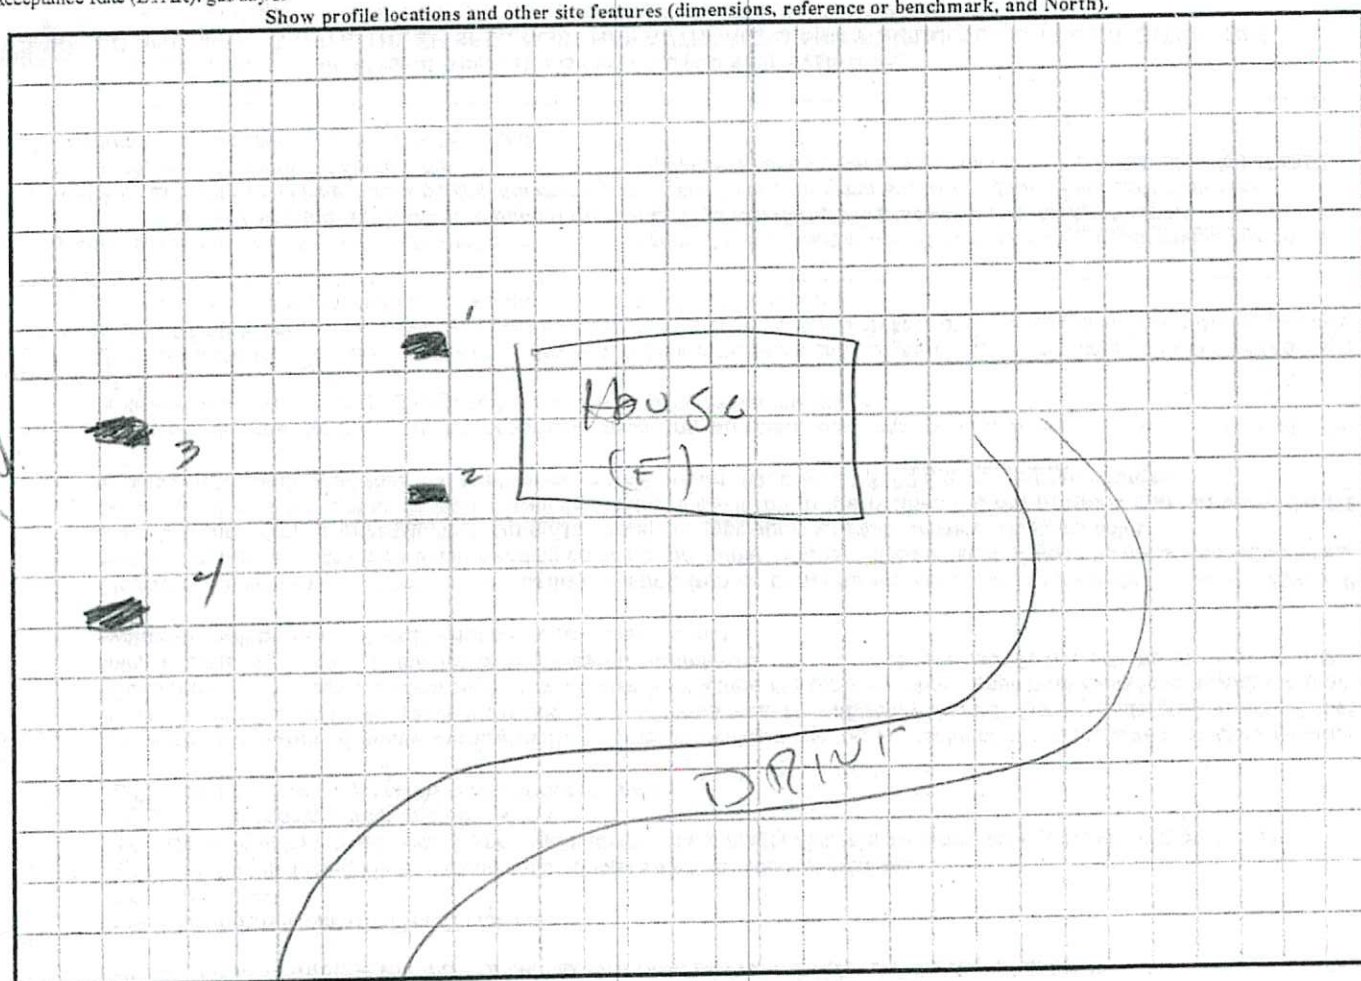

212 254

IREDELL COUNTY HEALTH DEPARTMENT
ENVIRONMENTAL HEALTH DIVISION
PAGE 1: APPLICATION FORM

Application For:

- ☒ Septic Improvement Permit ☐ New Well Permit ☐ Well Repair Permit ☐ Well Abandonment
☒ Authorization to Construct ☐ Existing System Inspection ☐ Septic System Repair

THE ABOVE PERMIT DOCUMENTS WILL BECOME INVALID IF INFORMATION PROVIDED ON THIS APPLICATION IS FALSIFIED OR CHANGED, OR IF THE SITE IS ALTERED. THE IMPROVEMENT PERMIT IS VALID FOR EITHER 60 MONTHS OR WITHOUT EXPIRATION DEPENDING UPON DOCUMENTATION SUBMITTED. APPLICATION WITH SITE PLAN 60 MONTHS, APPLICATION WITH COMPLETE, SCALED PLAT WITHOUT EXPIRATION. SEE 15A NCAC 18A .1937(f) FOR DETAILS.

Page 2: Site Plan Worksheet form MUST accompany this application

The following optional attachments may also be submitted:

Place an (X) beside whichever is submitted if applicable

- ☐ Survey Plat, scaled no more than 1 inch = 60 feet
☐ Custom Site Plan, scaled no more than 1 inch = 60 feet

Applicant Information:

Applicant Name: Maurice Lunsford Address: 2211 Jamesway Drive Phone: 704-437-3411
Owner Name: Maurice Lunsford Address: 2211 Jamesway Drive Phone: 704-437-3411

Property Information:

Street Address: 3460 Jennings Road, Union Grove, N.C. 28689
Subdivision Name: NONE Section/Phase: _____ Lot Number: _____
Driving Directions: Hwy 901 turn Left on Jennings Road, 1 mile on left.

Site Development Information: (check or complete ALL that apply)

- ☒ New Single Family Residence ☐ New Multi-Family Residence ☐ Accessory Building ☐ Bedroom(s) Addition
Maximum Number of Bedrooms: 4
Maximum Number of Occupants: 2
☐ Swimming Pool ☐ Other Addition/Structure: _____
☒ Crawl Space Foundation ☐ Concrete Slab Foundation ☐ Basement with Plumbing ☐ Basement without Plumbing

Non-Residential Site Development:

Type of Business: _____
Square Footage of Building: _____
Maximum Number of Employee: _____
Maximum Number of Seats/Beds/Other: _____

Water Supply:

- ☐ New Well ☐ Existing Well ☐ Community Well ☐ City Water ☒ Other Public Water IREDELL Water

Desired Septic System Type: (you may rank in order of preference)

Year existing system installed: _____

- ☐ No Preference ☐ Alternative ☐ Conventional ☐ Innovative ☐ Modified Conventional ☐ Other: _____

Please answer the following to the best of your ability:

- ☐ Yes ☒ No Does the site contain any jurisdictional wetlands?
☐ Yes ☒ No Is any non-domestic sewage (i.e. industrial) to be generated?
☐ Yes ☒ No Is the site subject to approval by any other public agency?

I have read this application and certify that the information provided herein is true, complete, and correct. Authorized county and state officials are granted right of entry to conduct necessary inspections to determine compliance with applicable laws and rules. I understand that I am solely responsible for the proper identification and labeling of all property lines and corners and making the site accessible so that a complete site evaluation can be performed.

Signature: _____

Property owner or owner's legal representative signature (SIGNATURE REQUIRED)

July 22, 2015
DATE

IREDELL COUNTY HEALTH DEPARTMENT ENVIRONMENTAL HEALTH DIVISION:

SITE PLAN WORKSHEET

SEE THE "SAMPLE SITE PLAN" BELOW. INCOMPLETE SITE PLANS WILL BE RETURNED TO YOU FOR COMPLETION AND MAY RESULT IN A DELAY IN THE ISSUANCE OF YOUR SEPTIC SYSTEM PERMIT!!!

Place an (X) beside each item as you complete the site plan:

☒ Property Line measurements are clearly identified...

☒ All proposed structures are indicated...

SHOW: proposed house or business footprint, wells, water lines, patios, pools and decks, and any other item that will occupy space on the site

☐ Front and side setbacks from property line...

☐ Preferred driveway location and configuration, preferred well location...

☐ Area you prefer your septic system to be placed...


☐ North arrow, or other sufficient indicator of direction...

Circle N/A on the following if appropriate:


☐ Location of septic systems and wells within 100' of your property... N/A

☐ Location of easements and rights of ways on your property... N/A

☐ Location of any designated wetlands on the property... N/A

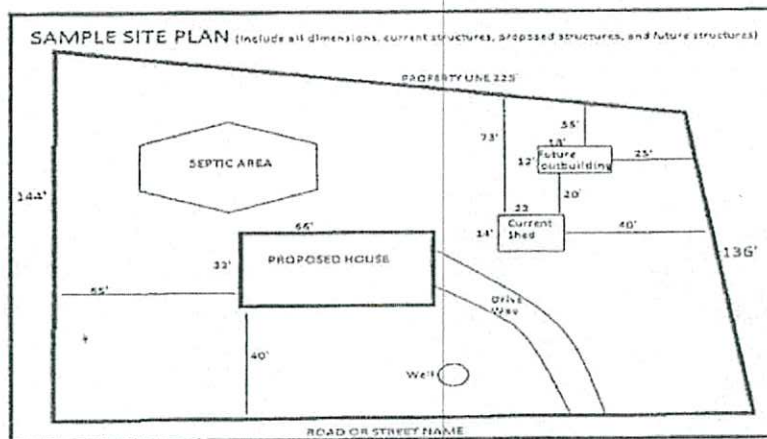

USE THIS SPACE TO DRAW YOUR SITE PLAN

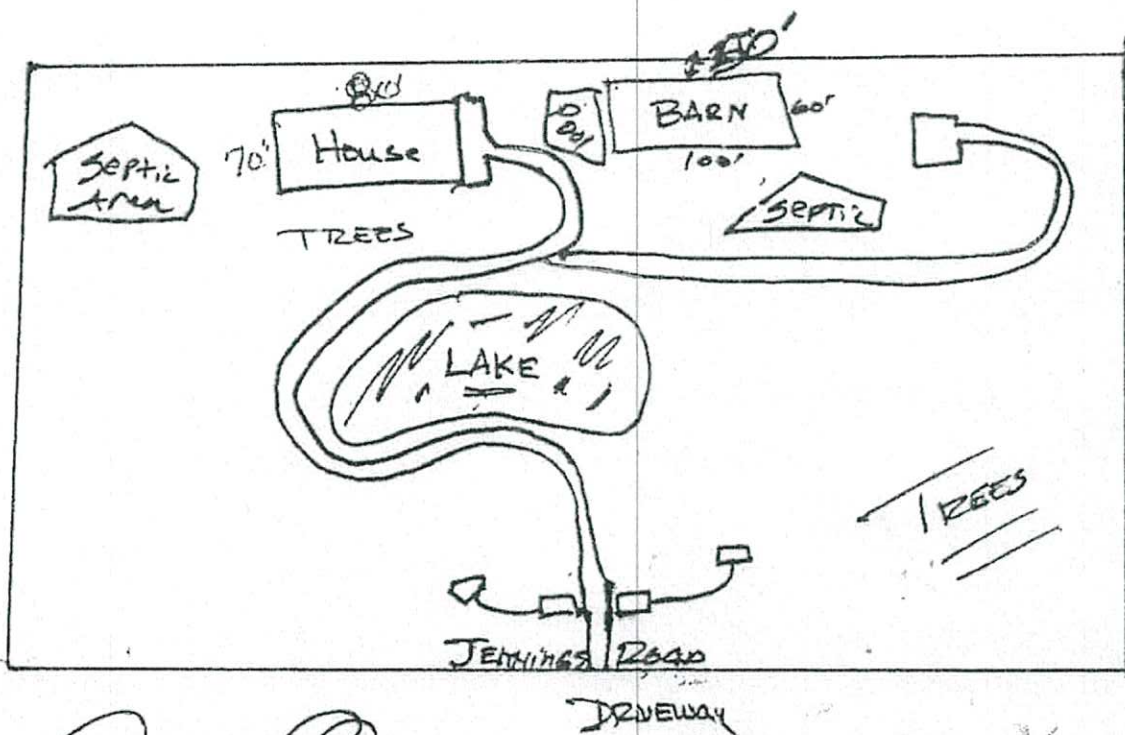

Signature:

REQUIRED property owner or owner's legal representative signature.

July 22, 2015

DATE

Plans ~~Submittal~~ ONLY!

Date 08/21/15

