

HEALTH DEPARTMENT


NUMBER	DATE	PIH
ST091 IMPROVEMENTS PERMIT	05.08.92	7377-02-7020
GUESTEE:	OWNER:	
ECHOLS ELIZABETH J 3502 38TH ST W BRADENTON FL 34205	ECHOLS, ELIZABETH J 3502 38TH ST W BRADENTON FL 34205	
TELEPHONE:	34205	
704.586-1004	Tina Pannico	
SPECIFICATIONS:		
3		
LOCATION/DIRECTIONS:		
OLD SHOOK COVE ROAD LOT #A		
FEE:	RECEIPT:	SIGNATURE OF OWNER OR AUTHORIZED AGENT:
30	9660	

The above signature indicates that I have read, understood and agree with all provisions and information as outlined on the back.

NOEDRMS 3 TYPE SYS 3E
SZ. TANK 900 *1000* *height* SZ. CHAMB Na NITRIFI 4.05 *4* OPER. RED Na
REMARKS: Stay 50' down high water mark of lake. T & E. Black Panel ((30') 18 Panels

Prompt Future Repair

NITRIF 4.06/4 OPER. REQ IVA
 L. T & J Block Panel (30') 18 Panels
 2 (1. new) Insull & Gas Manufacturing Reg
 Stg 8' Between Center
 Further Regras Stg in Natural s.
 Stg 10' from Wall
 of Lake
 Stg 5' from house

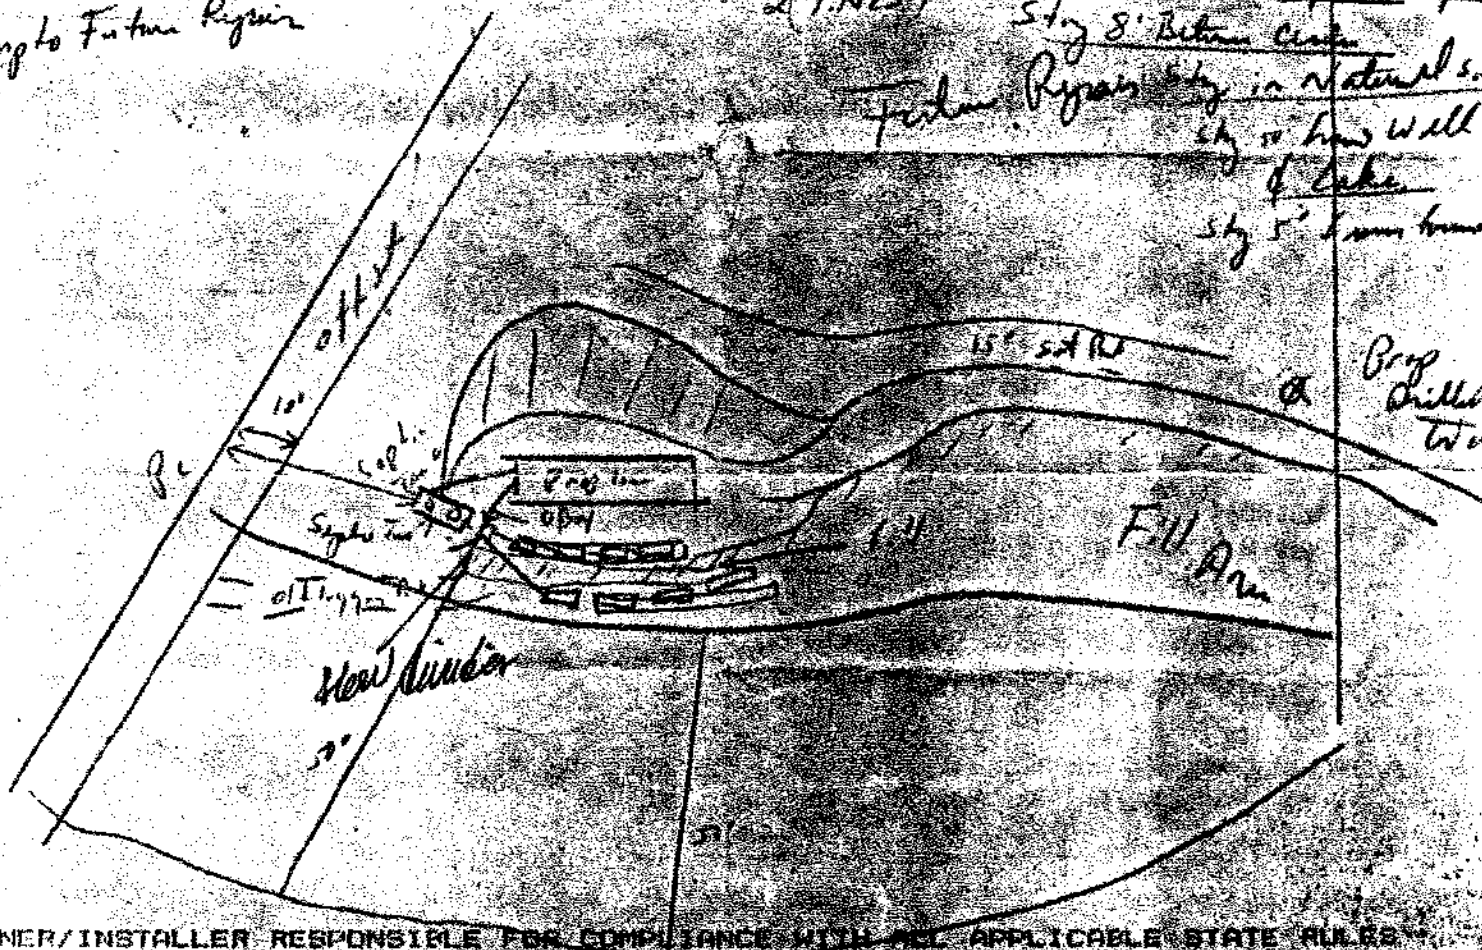

OWNER/INSTALLER RESPONSIBLE FOR COMPLIANCE WITH ALL APPLICABLE STATE RULES

DATE ISSUED 9/16/91

ENV. HEALTH SPEC *Samuel Bushman R.S.*

DATE APPROVED 9/2/92

ENV HEALTH SPEC *[Signature]*