



HAYWOOD COUNTY ENVIRONMENTAL HEALTH DEPARTMENT

157 Paragon Parkway Suite 200


Office: (828) 452-6682 Fax: (828) 452-6798

OPERATIONS PERMIT

Permit Number: WBL-2439 P.I.N Map# 8622 Block# 71 Lot# 1971 Permit Date: 2/17/14
Owner: CHARLES KOUNS & STELLA HUMPHRIES Associated Permits: _____
Subdivision: _____ Section No.: _____ Lot No.: _____
Property Location: BETWEEN TO HWY 215 SOUTH FROM LAKE LOGAN TO LEFT ON STEEL BRIDGE ROAD
CROSS RIVER TO HOUSE ON RIGHT
System Designed For: New ☒ Repair ☐ Addition ☐ Establishment: Residence ☒ Mobile Home ☐ Other ☒
Design Flow: 720 G.P.D. No. of Bedrooms _____ Other Establishment Type: 2 BEDROOM HOUSE AND 5 RV SITES
Basement: Yes ☒ No ☐ Sewer Outlet Location: FRONT Source of Water Supply: SPRING
The following items are on file and are part of this permit: ☒ GPS/GIS ☒ Application ☒ IP/CA ☒ Soil Sheet ☒ Map ☐ Plat Map ☐ Engineer's Drawing

Site Diagram (not to scale)

4 RV SITES

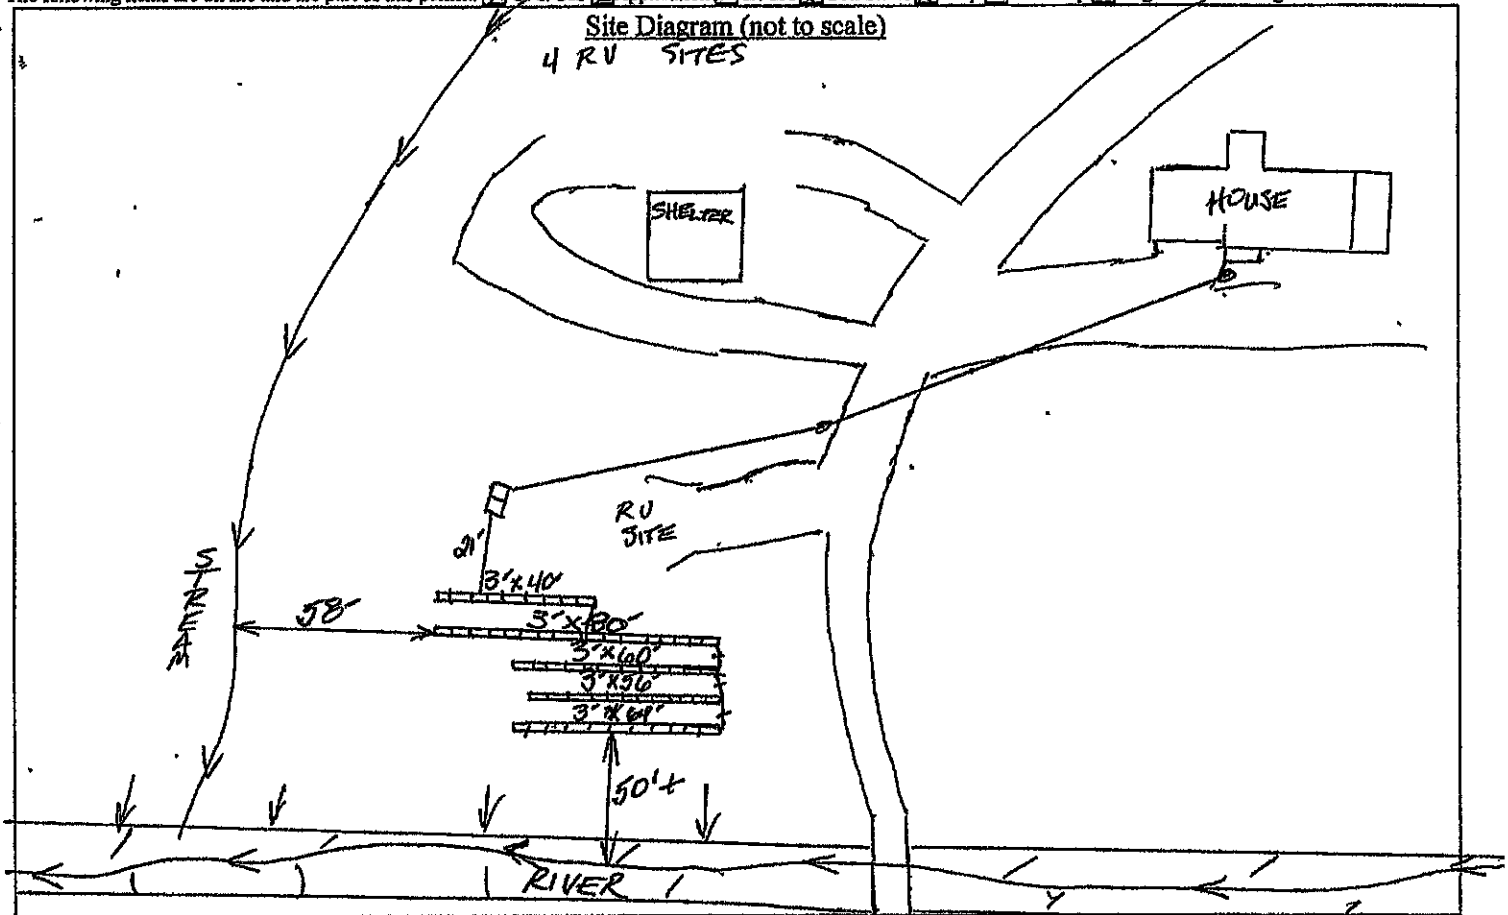

Septic Tank ☐ New ☒ Existing Material: CONCRETE Manufacturer: APRIME Capacity: 1600
☒ New Nitrification Field: SQ. Footage: 1200 Type: 25% REDUCTION No. Lines: 5 Length: 300' TOTAL
No. Units: _____ ☒ Gravity System ☐ Pump System Distribution: ☒ Serial ☐ Distribution Box ☐ Manifold
Pump Tank Manufacturer: _____ Material: _____ Capacity: _____
Pump Manufacturer: _____ Size: _____ Model No.: _____ Dosing: _____
Proposed Repair Type: _____ Area: _____ LTAR: _____ Saproliite: ☐ Yes ☐ No
For Repair or Addition: Existing SQ. Footage: _____ Type: _____ No. Lines: _____ Length: _____
Nearest Distance to: Water Supply: 50'± Stream: 58' Foundation: 100'± Property Line: 10'±
Installed by: BETS WADE Cert. #: _____ Inspection Date: 6/10/04 REHS: NEA
Remarks: _____

Approved: ☒ Yes ☐ No REHS: Damon Braden

Notice: Do not park, drive, or build over any part of septic system. Check tank for pumping and effluent filter at least every 3 years.
This approval is issued subject to all provisions of Article II, G.S. 130A 333-343 of the General Statutes of North Carolina and Laws and Rules for Sanitary Sewage Collection, Treatment and Disposal, 15A NCAC 18A, 1900. No person is permitted to make alterations in the design or use of this system other than its designated use without approval of an authorized REHS. This approval indicates that this system has been installed in compliance with the standards set forth in the above regulation, but shall in no way be taken as a guarantee that the system will function satisfactorily for any given period of time.

Doc. Operation Permit 11/1/13