

Georgia Department of Human Resources
ON-SITE SEWAGE MANAGEMENT SYSTEM INSPECTION REPORT

2-77061

County Code 141	Construction Permit 499	Case Number (FHA, VA, etc.) 2-77061	Health Dist. 04	Day 24	Month 06	Year 96
2 3 4	5 6 7 8	9 10 11 12 13 14 15 16 17 18 19 20	21 22	23 24	25 26	27 28

Property Location Lot 1 Pearther Farm	Property Owner Dele Harry	County Troup
	Sewage Disposal Contractor Mike Holbe	

ALL ITEMS: Blank = Not Applicable; 0 = Unknown

*ITEMS: 1 = Yes; 2 = No

SECTION A - GENERAL

- Type Water Supply:
(1) Public, (2) Community, (3) Indiv.
- Financial Assistance:
(1) FHA, (2) VA, (3) Farmers Home, (4) Conventional, (5) Other
- House Structure:
(1) New, (2) Existing < 1 year, (3) Existing > 1 year
- Sewage Disposal Installation:
(1) New, (2) Repair to existing sys.
- If Repair of Existing System - Years System Installed:
(1) < 1 year, (2) 1 - 2, (3) 2 - 3, (4) 3 - 5, (5) 5 - 10, (6) > 10
- Percolation Rate Min./In.:
- *Is Property Part of a Subdivision:

SECTION B - FACILITY

- Type Facility: See Code Below
- Water Usage Determined by:
(1) No. Bedrooms, (2) No. Gallons
- Number Bedrooms or Gallons:

SECTION C - LOT SIZE

- Lot Depth (Average):
- Lot Width (Average):
- Building Line (Feet):

SECTION D - PRIMARY TREATMENT

- Sewage Disposal Method:
(1) Septic Tank, (2) Construction Privy, (3) Pit Privy, (4) Aerobic Unit, (5) Other
- Septic Tank Capacity (gallons):
- Unit 1 Tank/Compartment Capacity:
- Septic Tank Inside Length (feet):
- Septic Tank Inside Width (feet):
- Septic Tank Liquid Depth (feet):
- Septic Tank Material:
(1) Precast concrete, (2) Poured in place, (3) Other
- Dosing Tank Capacity (gallons):
- Grease Trap Capacity (gallons):
- Distance Septic Tank from Well:

SECTION E - SECONDARY TREATMENT

- Field Layout Method:
(1) Distribution Box, (2) Level Field, (3) Serial, (4) Mound, (5) Other
- Absorption Field:
a. Total Square Feet

- Total Linear Feet
- Length each Trench (feet): **55+55+65+75**
- Width of Trenches (inches)
- Number of Trenches
- Distance between Trenches
- Average Trench Depth (inches)
- * Aggregate Proper Size
- * Aggregate Proper Depth
- Distance from Building Foundation
- Nearest Property Line:
(1) Front, (2) Rear, (3) R. Side, (4) L. Side
- Distance Nearest Property Line
- Distance Privy or Absorption Field from Well


SECTION F - HEALTH AGENCY TIME

- Total Inclusive Time (min.):

SECTION G - SYSTEM APPROVED

- * Yes
- No

Sketch

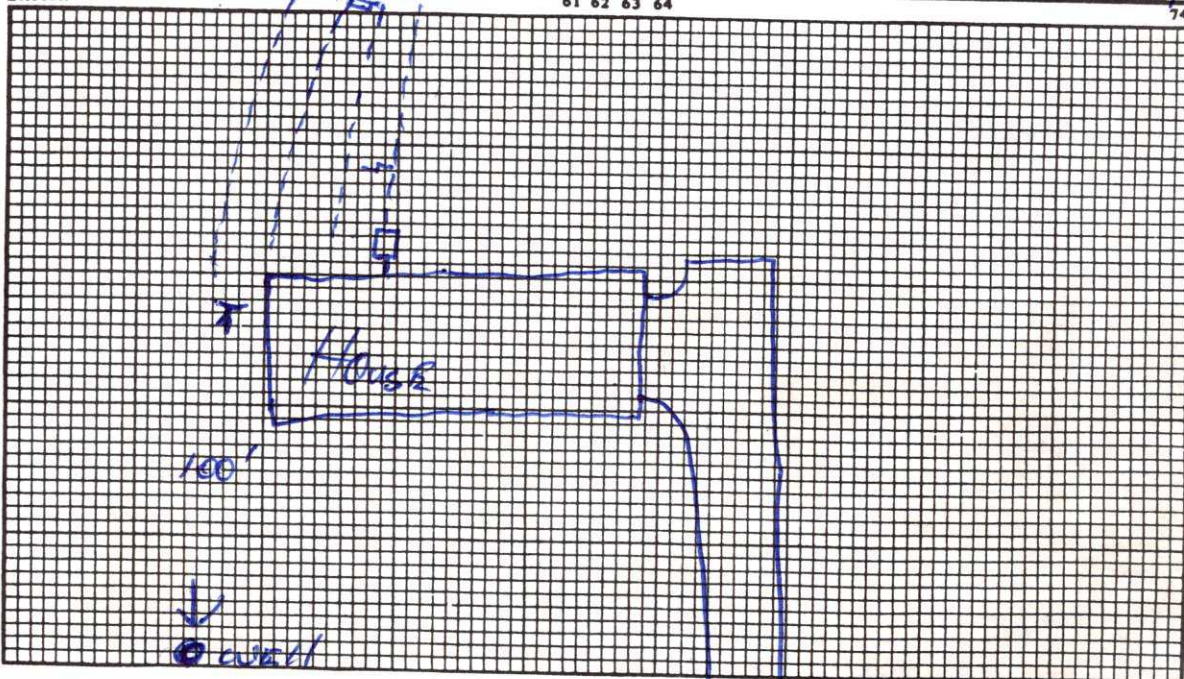

- Type Facility:
(1) Residence
(2) Apartment
(3) Institution
(4) Service Station
(5) Restaurant
(6) Church
(7) Tourist Accommodation
(8) Launderette
(9) Mobile Home Park
(10) Other
(Specify) _____

Remarks:

Inspected By: Kathy West	Title: EHS II	Health Agency: Troup
------------------------------------	-------------------------	--------------------------------