


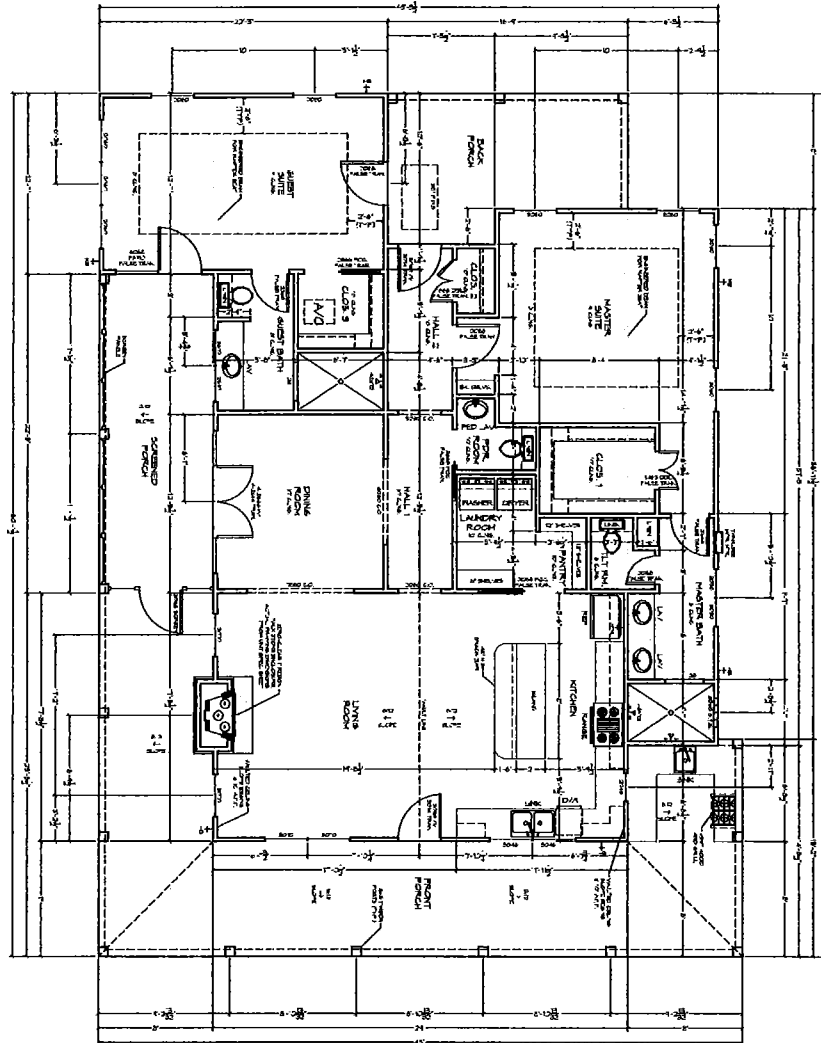

1 FLOOR PLAN - MAIN LEVEL



Scale: 1/8" = 1'-0"

AREA DATA	
HEATED - MAIN LEVEL	1685
TOTAL HEATED	1685
FRONT PORCH	153
BACK PORCH	112
TOTAL AREA UNDER ROOF	1950

Residence For:  
Stan Delahousaye  
Tim Louis

**PMD** Designs

Custom Drafting & Design  
106 S. Wofford St. - Athens, Texas 75751  
903-675-6887 P/F - 903-477-0039 C

Drawn By:  
Felix McLaughlin

DATE:  
01-27-12

PROJECT NAME:  
FLOOR PLAN

SHEET NO:  
2 of 2

**Note:**

1. Area identified on plans as “screened porch” was enclosed as air conditioned space during construction.
2. The 178 sq. ft. of “screened porch should be added to the 1,695 sq. ft. of heated/cooled space for total of 1,873 sq. feet in main building.
3. There is another 160 square feet of air conditioned space in guest quarters, bringing total to 2,033 square feet of air conditioned space.
4. The grill indicated in the plans in outdoor kitchen was never built due to concerns about ventilation. Instead, a portable grill (an “egg”) was installed on the patio immediately next to the outdoor kitchen.
5. The front porch was screened post-construction and is not indicated on the plans.