


RECEIVED & FILED
 Vilas County Surveyor's Office
 Date 10-25-19
 By R
 VCS File No. L2142

Parcel No. 16-148-05

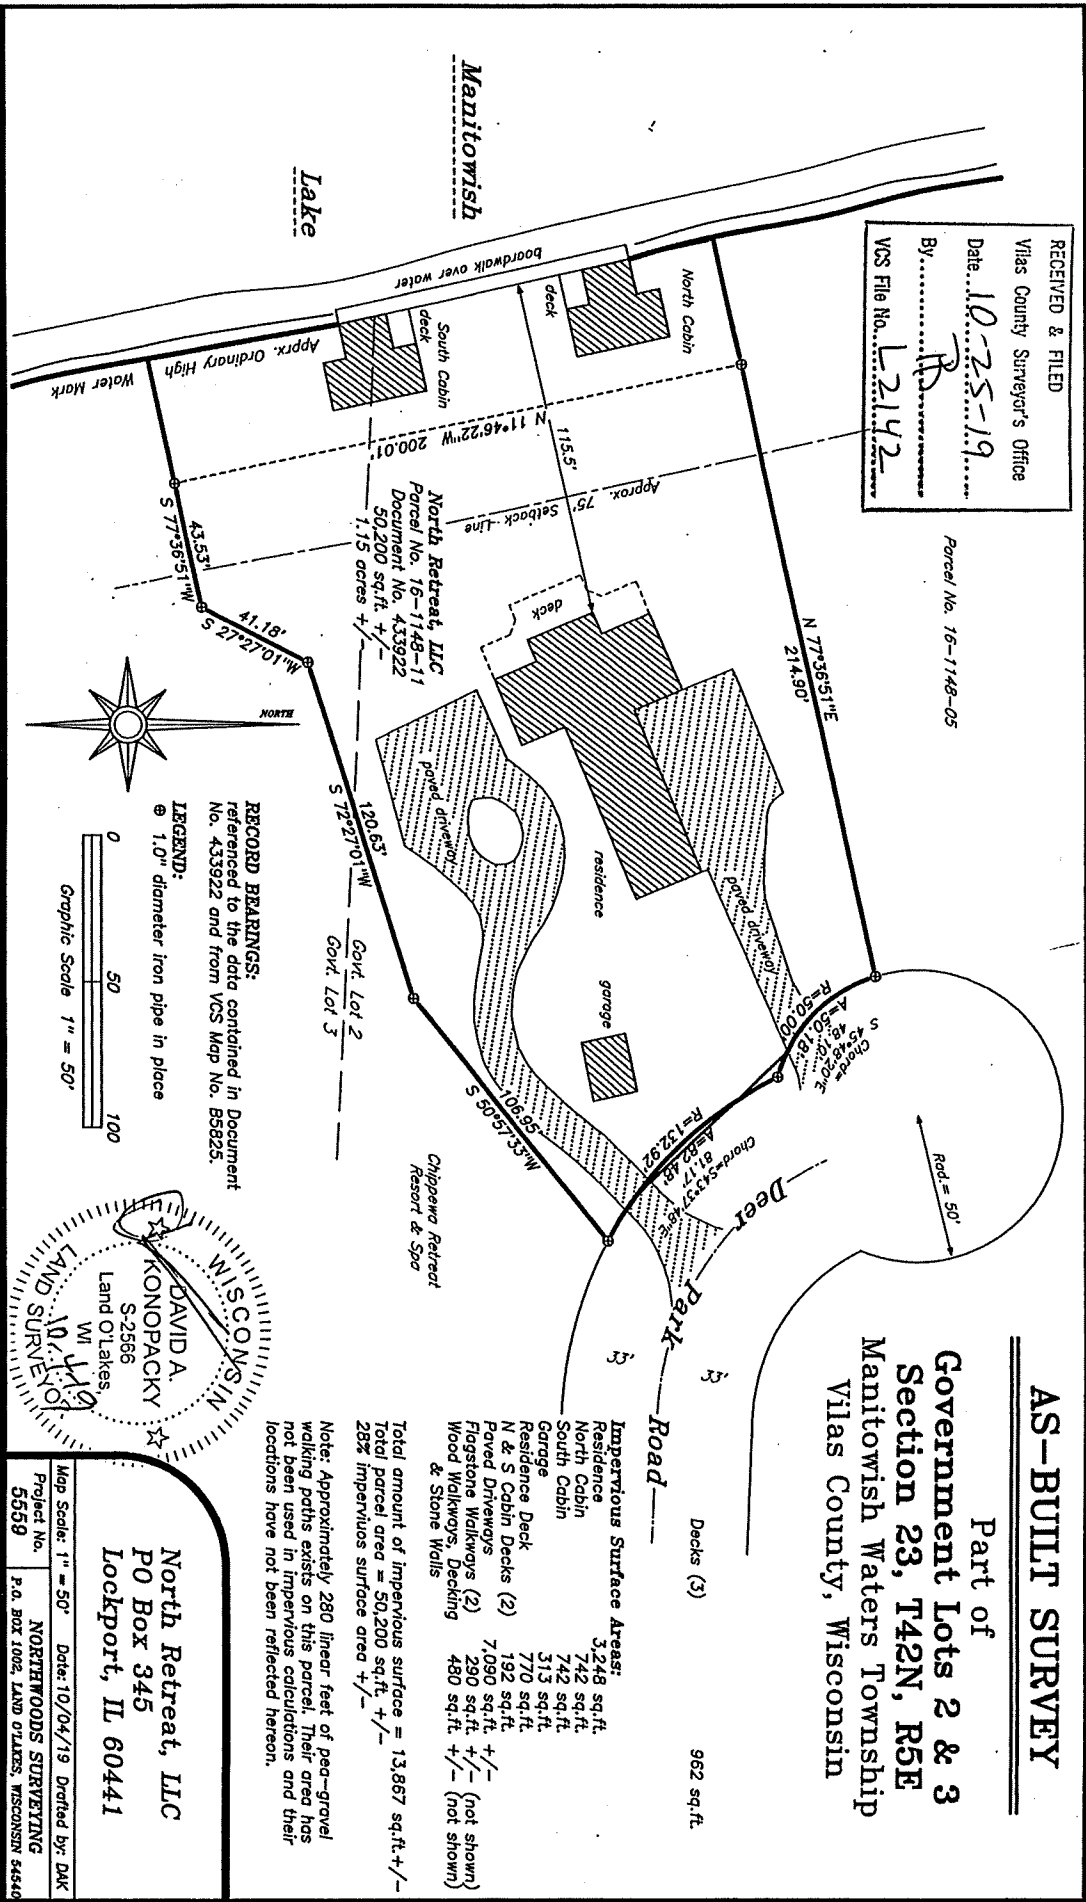

AS-BUILT SURVEY Part of **Government Lots 2 & 3** **Section 23, T42N, R5E** **Manitowish Waters Township** **Vilas County, Wisconsin**

ImperVIOUS Surface Areas:



Residence	3,248 sq.ft.
North Cabin	742 sq.ft.
South Cabin	742 sq.ft.
Garage	313 sq.ft.
Residence Deck	770 sq.ft.
N & S Cabin Decks (2)	192 sq.ft.
Paved Driveways	7,090 sq.ft. +/-
Flagstone Walkways (2)	290 sq.ft. +/-
Wood Walkways, Decking & Stone Walls	480 sq.ft. +/- (not shown)

Total amount of imperVIOUS surface = 13,867 sq.ft. +/-
 Total parcel area = 50,200 sq.ft. +/-
 28% imperVIOUS surface area +/-

Note: Approximately 280 linear feet of peg-gravel walking paths exists on this parcel. Their area has not been used in imperVIOUS calculations and their locations have not been reflected hereon.

RECORD BEARINGS:
 referenced to the data contained in Document No. 433922 and from VCS Map No. B5825.

LEGEND:
 @ 1.0" diameter iron pipe in place

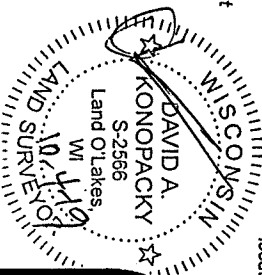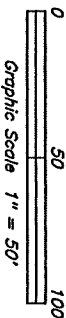

North Retreat, LLC
P.O. Box 345
Lockport, IL 60441

Map Scale: 1" = 50' Date: 10/04/19 Drawn by: DAK
 Project No. **NORTHWOODS SURVEYING**
5559 P.O. BOX 1002, LAND CLARK, WISCONSIN 54540





