

Permit # OSC 061- 03061

**Gilmer County Board of Health
ENVIRONMENTAL HEALTH DEPT.**

**ON-SITE SEWAGE MANAGEMENT SYSTEM
INSPECTION REPORT AND PERMIT**

S/D & Lot #: The Hammock LOT 4
Directions:

PROPERTY OWNER & ADDRESS

Arnold Building Group

Hwy 5 South RT/Roundtop Rd
LT into SD 4th lot on RT

Phone: 404-401-4278

Email: arnolddbuildinggroup1@gmail.com

110 Sunset Cv

I hereby apply for a permit to install or construct an individual On-Site Sewage Management System (OSSMS) and agree that the system will be installed to conform to the requirements of the Georgia Department of Public Health, Chapter 511-3-1 and current Gilmer County Board of Health requirements. I understand that final inspection is required and will notify the Gilmer County Environmental Health Department at 706-635-6050 upon completion and before applying final cover to the OSSMS.

I understand that neither this permit, soil evaluation nor final inspection in any way guarantees the proper operation or functioning of the sewage system or in any way confers any liability or warranty of any kind upon the Gilmer County Board of Health, Georgia Division of Public Health, omits representatives.

I understand that this Permit will EXPIRE (12) months from the Issue Date

Signature: [Signature]

Date: 3/30/21

General Permit/Specifications:

Water Supply: Private (Well/Spring) ☒ Public
Community Other

Facility Type: ☒ Residential (Single Family / Multi Family)

Other
Commercial

No. of Bedrooms: 3 or Gallons per Day

Garbage Disposal: Yes ☒ No *If Yes, Increase Tank Size by 50%

Basement: Y N Unfinished/Finished Plumbing? Y N

Lot Size: 1.15 TSF of Structure:

Type of System:

☒ New Addon Conventional
Repair Existing Alternative
Other

Min. Requirements:

Septic Tank: 1000 gals.

Dosing Tank: gals.

Absorption Field/Gravel Specifications:

a) Perc Rate 45 BRASSSTOWN ☒

b) Sq. Ft. 900

c) Linear Ft. 300

Trenches:

a) width 3 ft.

b) depth 24-36 in.

c) distance between 7 ft.

System Requirements Met?

YES NO N/A

☒ ☐ ☐

☐ ☐ ☐

☐ ☐ ☐

PERMIT APPROVAL

Insp. A Mathis

Date 3/30/21

☒ Approved

☐ Denied

☐ As Repair

SYSTEM APPROVAL

Insp. DL

Date 4/26/21

☒ Approved

☐ Denied

☐ As Repaired

Permit Conditions and/or Requirements:

- DO NOT CUT SITE DOWN
- SYSTEM TO BE INSTALLED UPPER RIGHT REAR AVOIDING POWER LINE EASEMENT.
- INSTALL FIRST

OSSMS must be installed first. Must obtain Land Disturbance permit prior to any grading and/or site modifications.

Septic Tank Dist. Met? Well/Spring = 50' min Y N/A Creek, etc = 25' min Y N/A


Absorption Field Dist. Met? Well/Spring = 100' min Y N/A Creek, etc = 50' min Y N/A

Tank CP 1000 Filter Type Polylok Field Material Q4THC

% Reduction 35% Well Installed: Y N/A

Installer MILES PHILLIPS Cert # RD

Final Drawing: EASEMENT

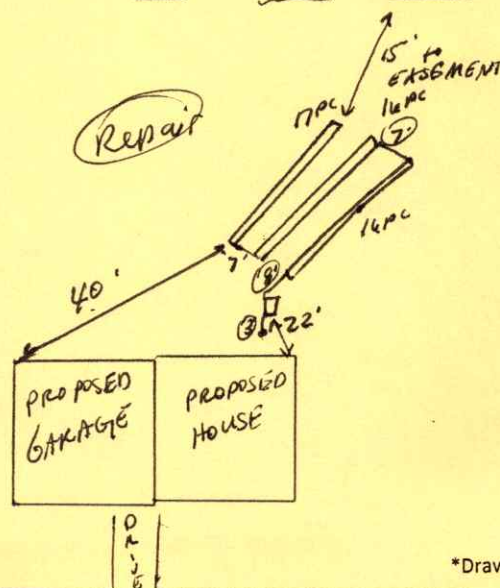

Drawing Not to Scale