

Mohave County Development Services

P.O. Box 7000 ♦ Kingman, Arizona 86402-7000
3250 E Kino Ave ♦ Kingman, Arizona 8640
(928) 757-0903 ♦ FAX 757-3577
1130 East Hancock Road ♦ Bullhead City, Arizona 86442
(928) 758-0707 ♦ FAX 763-0870

DISCHARGE AUTHORIZATION

FOR AN ONSITE WASTEWATER TREATMENT
FACILITY
TYPE 4.02 THROUGH 4.22 GENERAL PERMITS

Permittee Information	County: Mohave
Applicant: MAIN CONSTRUCTION AND LANDSCAPE LLC	Agency #: 11 - Kingman City-County
Address: KINGMAN, AZ	Owner Name: SEAVER JONATHON A & BRANDY J
	Permit #: EQS-2025-00027
	Permitted Design Flow: 450
Address of Facility (if different from above): 0 KINGMAN, AZ GOLDEN VALLEY RANCHOS UNIT ONE BLK N LOT 8	Number of Bedrooms: 3
	Number of Fixture Units: 21
	Parcel Number: 215-05-211

Characteristics of the Wastewater Sources:	Township 20N Range 18W Section 15
Yes Typical Sewage, single-family residence	
No Typical Sewage, multi-family residence	Latitude: 35 Degrees 6 Minutes 46.89 Seconds
Sewage source(s), commercial (specify all)	Longitude: 114 Degrees 10 Minutes 48.95 Seconds

Record Documents (Must be maintained with this Authorization)	Dated	Applicable General Permit Numbers (specify each applicable CP, 4.02 through 4.22)
Yes Notice of Intent to Discharge	1/7/2025	4.02 - Septic and/or Conventional, Primary
Yes Site Investigation Report (original)	1/3/2025	
Yes Site Plan and Configuration Page	1/7/2025	
Yes Construction Authorization	3/7/2025	
Yes Request for Discharge Authorization	3/25/2025	
Yes Field Watertightness Test Certification for Septic Tank	3/25/2025	
As-built constructions plans		
Final List of Materials and Equipment		
Final Operation and Maintenance Manual		
Service Contract (1 yr - 4.03-4.22 only)		
Certificate of Completion		
Other (specify):		

Review Agency Notes:

1000 GALLON TANK * SYSTEM SIZED FOR MAX 3 BEDROOMS & 21 FIXTURE UNITS * MUST NOT DRIVE OVER OR BUILD OVER SYSTEM * HIGHLY RECOMMEND NOT BUILDING OVER RESERVE AREA

Construction Authorization Stipulations: This Construction Authorization is issued in accordance with Arizona Administrative Code Title 18, Chapter 9, Article 3. The Applicant is authorized to construct the facility at the location specified herein based on the listed design documents under the terms and conditions of the checked General Permit numbers and the requirements of Arizona Revised Statutes Title 49, Chapter 2. The Applicant has two years from the approval date of this document to complete construction and submit the Request for Discharge Authorization form and any additional required documents specified in A.A.C. R18-9-A309(C) or the checked General Permits. Construction shall conform with the approved design documents. Fees are not refundable. Permit is not transferable.

Approved By: _____ **Title:** _____ **Approval Date:** _____

This Construction Authorization is not valid until signed by the applicant as an acknowledgement of all conditions contained in the Construction Authorization and picked up from Environmental Quality office. A copy of the Construction Authorization and septic plot plan must be kept at the job site at all times.

ON-SITE WASTEWATER SYSTEM SITE PLAN

(for 4.02 General Permit only. 4.03-4.22 must provide construction quality drawings)

Address:	☐ North Arrow shown
Assessor Parcel: 215-05-211	☐ Boundaries of property shown on plan
Legal Description: GOLDEN VALLEY RANCHOS UNIT ONE BLK N LOT 8	☐ Proposed/existing systems, dwellings, buildings, driveways, swimming pools, tennis courts, wells, ponds, and any paved, concrete or water feature, shown.
	☐ Slopes and cut banks greater than 15%, retaining walls and other constructed features shown
	☐ Any feature less than 200 ft. from facility and reserve area that constrains the location due to setback limitations shown
	☐ Topography shown with contour intervals, showing original and post-installation grades
Property Size (in acres): 2.35	☐ EXACT LOCATION of all soils testing and percolation sites
Engineer's Scale (max 1"=60'): 1" = 60'	☐ Location of the treatment and disposal works, pipelines, reserve area
Permit Number:	☐ Location of any public sewer if less than 400 ft. from property line

**ELECTRONIC CONSTRUCTION AUTHORIZATION
PROPOSED PLAN** EQS-2025-00027

BY: *Crystal McKee* 3/3/2025

MOHAVE COUNTY DEVELOPMENT SERVICES DEPT
DIVISION OF ENVIRONMENTAL QUALITY/
WASTE DISPOSAL SERVICES


NOT VALID UNLESS DIGITALLY COUNTERSIGNED

**ELECTRONIC DISCHARGE AUTHORIZATION
FINAL AS-BUILT**

BY:

MOHAVE COUNTY DEVELOPMENT SERVICES DEPT
DIVISION OF ENVIRONMENTAL QUALITY/
WASTE DISPOSAL SERVICES

NOT VALID UNLESS DIGITALLY COUNTERSIGNED

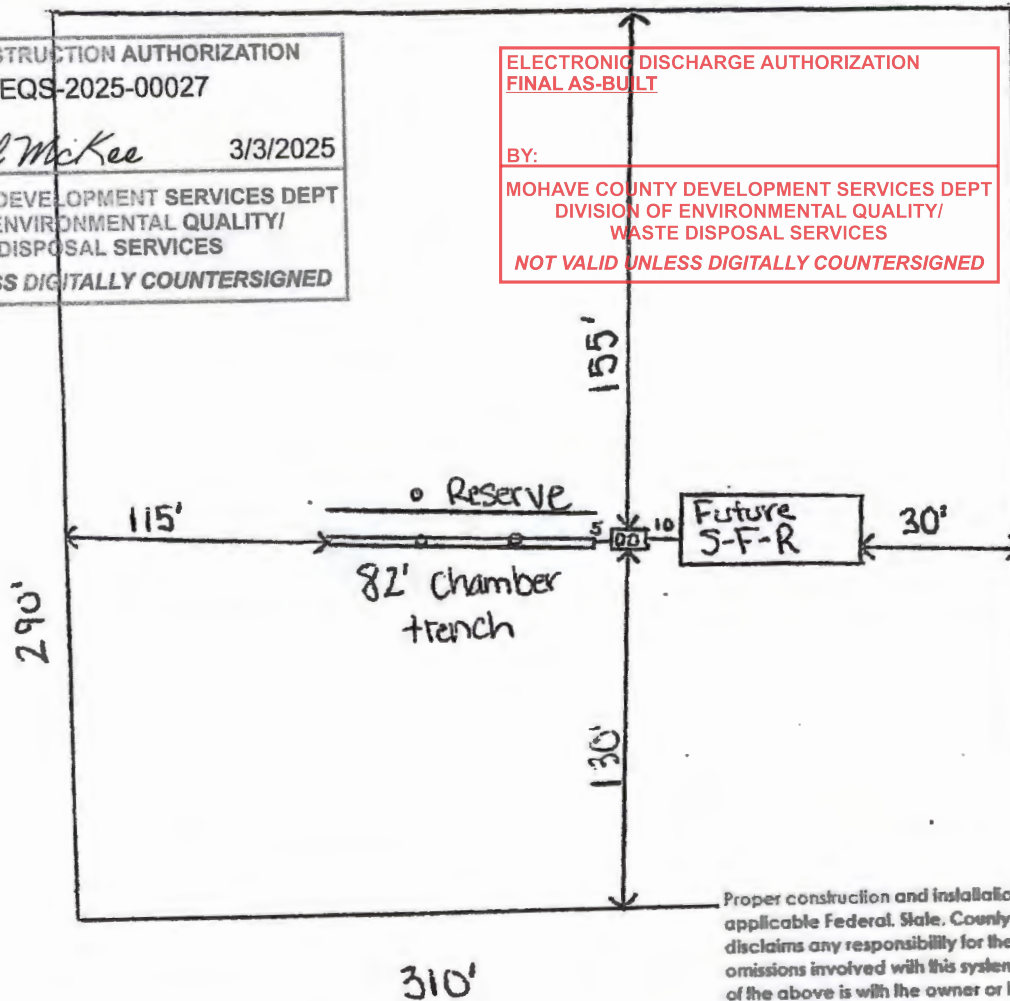

Proper construction and installation of this system shall follow all applicable Federal, State, County and City laws. Mohave County disclaims any responsibility for the construction, installation, errors or omissions involved with this system and the sole responsibility for any of the above is with the owner or his/her contractor(s) and/or agent(s). The as-built drawing is provided for ease and convenience to locate the system in the future and not for construction purposes.

W Aquarius Dr

Proper construction and installation of this system shall follow all applicable Federal, State, County and City laws. Mohave county disclaims any responsibility of the construction, installation, errors or omissions involved with this system and the sole responsibility for any of the above is with the owner or his/her contractor (s) and/or agents (s). The as-built drawing is provided for ease and convenience to locate the system in the future and not for construction purposes.

The information within the site plan submitted is true and accurate to the best of my knowledge;

[Signature]
Signature

installer
Title

Date: 1/7/2025

PERMIT EQS-2025-00027

Contractor MAIN CONSTRUCTION

APN 215-05-211

Phone 928-530-1659

Address _____

Approved System Design RESIDENTIAL 1000 GALLON TANK DESIGNED FOR 3 BDRM 21 FIXTURES AND 450 GPD

▪ Request for Discharge Authorization received ☒ Yes ☐ No Dated 3/25/2025
 ▪ Water Tightness Certification received ☒ Yes ☐ No Dated 3/25/2025

INSPECTION CHECKLIST OF ON-SITE WASTEWATER SYSTEM

- System has been left uncovered for inspection ☒ Yes ☐ No
- Property Boundaries are visibly marked – four corners ☒ Yes ☐ No
- All required setbacks met, (buildings, easements, drainage easements, washes, driveways, property lines, slopes, etc.) ☒ Yes ☐ No
- Design and construction verified ☒ Yes ☐ No
- Installed tank size as per approved plan ☒ Yes ☐ No Actual tank size installed 1 Kgal.
- GPS coordinates taken at the inlet of the tank ☒ Yes ☐ No ☐ N/A
- Inlet and Outlet T is stable and level ☒ Yes ☐ No ☐ N/A
- Risers, if required, are in place ☐ Yes ☐ No ☒ N/A
- Seal around inlet & outlet of septic tank checked to insure water tightness ☒ Yes ☐ No ☐ N/A
- Effluent filter in place ☒ Yes ☐ No ☐ N/A
- Tank is level ☒ Yes ☐ No ☐ N/A
- Five feet of solid pipe between tank and leach field ☒ Yes ☐ No ☐ N/A
- Leach field pipe level ☒ Yes ☐ No ☐ N/A
- The ends of the leach lines capped and exposed for inspection ☐ Yes ☐ No ☒ N/A
- Size of gravel is uniform. 3/4" - 2 1/2" in diameter and clean ☐ Yes ☐ No ☒ N/A
- Laterals connecting multiple lines are solid pipe ☐ Yes ☐ No ☒ N/A
- If multiple lines present, even distribution is achieved & distribution box present and level ☐ Yes ☐ No ☒ N/A
- Sufficient room available for reserve area ☒ Yes ☐ No
- Lot is vacant ☒ Yes ☐ No

☒ Yellow tag issued: system can be covered - Final Approval paperwork to follow.

☐ Red tag issued: requirements are not met, contact inspector – Corrections must be made before backfilling.

☐ Blue tag issued: all required documents have not been received - If alternative system, Engineer's Certificate of Completion is required.

Latitude 35 ° 112 ° 181 "N

Longitude 114 ° 180 ° 375 "W

Date of Inspection 3/27/25

Inspector Signature [Signature]

☒ Inspection entered

667
35.112530

114.18053 W
356