

FINAL/AS-BUILT - Subsurface Sewage Disposal



Public Health
Prevent. Promote. Protect.
Idaho Public Health Districts

SOUTHWEST DISTRICT HEALTH

13307 Miami Lane
Caldwell, Idaho 83607
(208) 455-5300

Permit #: 012147

Date Rcvd: 10/06/2022

Parcel #: R29983

Applicant's Name: SRM CONSTRUCTION INC
Owners Name: STEPHEN J COLLIAS
Property Address: 11171 PUMP ROAD NAMPA ID 83686


EHS: Tim Eylar

Legal Description: Township: 2N Range: 3 Section: 3W

Notes/ Conditions of Approval:

Nampa Drain and Septic
1-1146

Lake Shore Drive

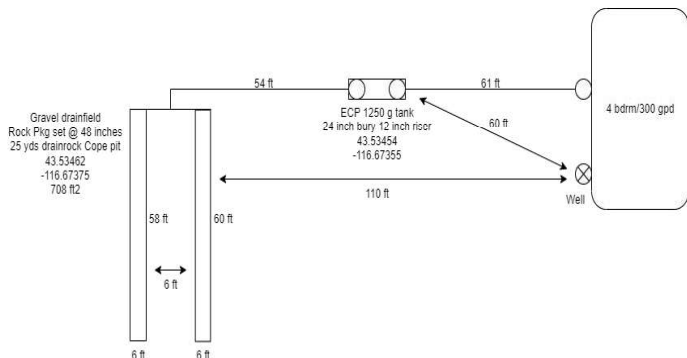

System Type: Gravel Drainfield	Gravel (Yards): 25
System Mfg: N/A	Sand (Yards): N/A
Septic/ Trash Tank (Gal): 1250	Installation Depth (Inches): 48
Septic/ Trash Tank Mfr: ECP	Date Installed: 10-03-2022
Depth to Tank Lid (inches): 24	Rock Under Pipe (Inches): 6
Standpipe/ Riser (inches): 12	Riser Longitude: -116.67355
Pump Tank (gallons): N/A	Riser Latitude: 43.53454
Pump Tank (Mfg): N/A	Well Installed ☒ Yes ☐ No
Drainfield Width (Ft): 6	Distance to Tank Ft: <u>60</u>
Drainfield Length (Ft): 118	Distance to Drainfield (Ft): <u>110</u>
Drainfield Area Installed (Sq. Ft.): 708	Valve: ☐ Yes ☒ No
Effective Area (Sq. Ft.): 708	Dist-Box: ☐ Yes ☒ No
Drop-Box: ☐ Yes ☒ No	
All plans, specifications, and conditions contained in the approved permit application are hereby incorporated into and may be enforceable as part of the permit.	

Technical Allowance Granted: ☐ Yes ☒ No

Comments:

Installer Name: Nampa Drain & Septic

Installer Number: 1-1146

Signature: _____

Date: 10/06/2022

By signing above, I certify that all answers and statements on this Final As-built are true and complete to the best of my knowledge.
OFFICIAL USE ONLY

☒ As-Built provided by EHS

☐ As-Built provided by Installer

Tim Eylar

EHS Final Inspection Signature

017

EHS Code

Digitally signed by Tim Eylar
Date: 2022.10.06 15:50:49 -06'00'

10/06/2022

Date

Permit #: 012147

10/06/2022



(No Subject)