

SOUTHWEST IDAHO HEALTH DEPARTMENT
INDIVIDUAL SEWAGE DISPOSAL PERMIT APPLICATION

2435 Schiller

Town & Range Sec 13

T2-36687

Date 8-3-73

Installation for

Location

VERN CRANK - RT. 1 BOX 290

New ☐ on existing ☒ ~~EXISTING~~ $\frac{1}{2}$ m W OF MILL

Bedrooms: Tank size Drainfield size

Seepage pit ☒ Field drain ☐ Absorption bed ☐ Raised System ☐

Water Supply: Public ☐ Private ☒ Distance to Well

Distance to other wells Distance to water lines Distance to surface water


Feet to water table Feet to lava

Test hole yes ☐ no ☐ Percolation test yes ☐ no ☐ Results

(Sketch showing all pertinent measurements)

X

water at 5.5

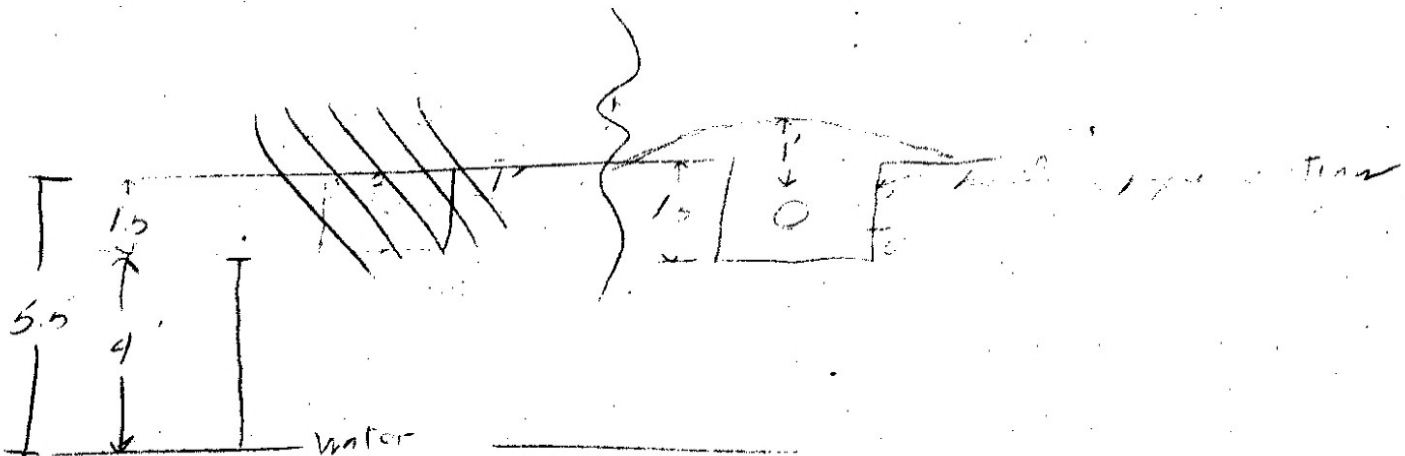

Vern Crank

X X

Applicant's Signature

Owner ☐ Builder ☐ Installer ☐

Application Approved ☐

Application Not Approved ☐

Application Approved with changes shown ☐

By

Environmental Health Specialist

KO