

Final/AS-BUILT-Subsurface Sewage Disposal



Public Health
Prevent. Promote. Protect.

Idaho Public Health Districts

Central District Health
707 N. Armstrong Place
Boise, ID 83704
(208) 327-7499

File # 166045




Owner's Name: Thomas Tribble
Property Address: Clear Creek Road
Boise, ID 83716

Phone # 208-818-6785

Legal Description: 1/4	1/4	Section:	Township:	Range:
Subdivision: 677 Timber Mountain Ranch 3	Lot: 1	Block:	Size(acres) 34.29	

As-built (not to scale)

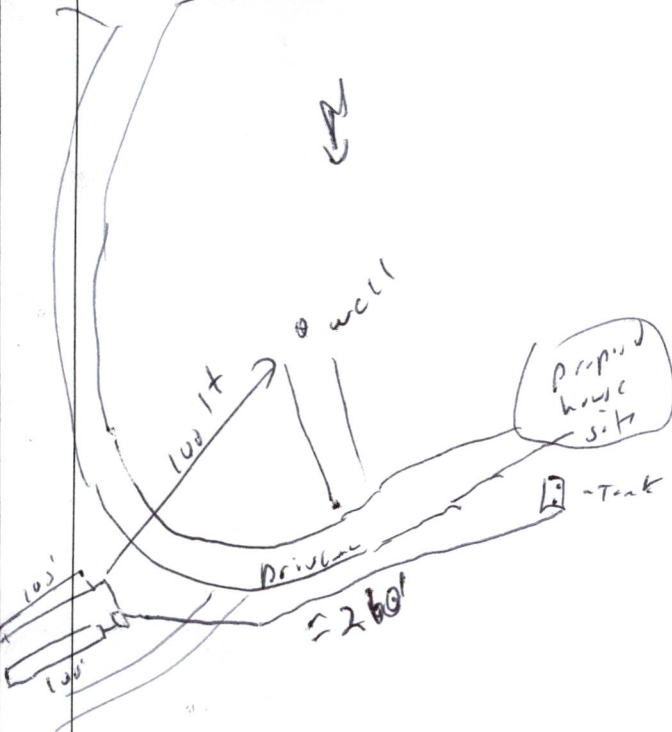

System Type : <u>Exter Drainage</u>	Gravel (yards) : <u>NA 95</u>
System Mfg : <u>NA</u>	Sand (yards) : <u>NA</u>
Septic/Trash Tank (Gal) : <u>1500</u>	System Depth (inches) : <u>36"</u>
Septic/Trash Mfr : <u>Linker</u>	Rock Under Pipe (inches) : <u>18"</u>
Depth to Manhole Lid (inches) : <u>12.1</u>	Date System Installed : <u>5-11-22</u>
Standpipe/Riser (inches) : <u>NA</u>	Drainfield Latitude : <u>N. 43.43.437</u>
Pump Tank (Gal) : <u>NA</u>	Drainfield Longitude : <u>W. 116.00.752</u>
Pump Tank Mfg : <u>NA</u>	Well Installed ☒ Yes ☐ No
Drainfield Width (ft) : <u>6</u>	Distance to Tank (ft) : <u>50 ft</u>
Drainfield Length (ft) : <u>200</u>	Distance to Drainfield (ft) : <u>100 ft</u>
Drainfield Area (sq ft) : <u>1200</u>	Valve : ☐ Yes ☒ No
(Installed sq ft) : <u>1500</u>	Dist-Box : ☒ Yes ☐ No
(Effective sq ft) : <u>1500</u>	Drop-Box : ☐ Yes ☒ No
Technical Allowance Granted: ☐	
Number of Bedrooms:	Gallons Per Day:

Well: N. 43.43.420 W. 116.00.783

Notes/Conditions of Approval: 783

On-site wastewater systems installation approved: ☒

Installer Name: Bruce Bernhoff Const.
Installer Phone:
Installer Number: 477255

Signature: _____
Date: _____

By signing above, I certify that all answers and statements on this Final/As-Built are true and complete to the best of my knowledge.

Official Use Only

- ☒ As-Built provided by EHS
☐ As-Built provided by Installer

EHS Final Inspection Signature EHS

Code:

0068

Date:

5-11-22