

West Virginia Department of Health & Human Resources
Braxton County Department of Health

Permit #: ST-04-23-05Deed Bk: 561 Page #: 067Map #: 2-M Parcel #: 29Coordinates: N 38°19'32"W 80°59'26"**ON-SITE SEWAGE DISPOSAL SYSTEM**

Owner: Douglas & Molly Pengemk
Address: 6652 Servia Elmira Rd
Duck, WV 25063

Installer: Charles McCumber
Address: 190 McCumbers Min
Gassaway, WV 26624

Property Location:

6652 Servia Elmira Rd, Duck, WV 25063

Subdivision: _____ Lot Number: _____

Facility Type: Residential Facility is: ☐ New ☒ Existing Lot Size: 38 AcresSystem Design Loading: 3 BR Water Source: Private ☒ Existing ☐ ProposedSystem requires a perpetual maintenance program as per §64CSR9.7.2: ☒ Yes ☐ No**SEWAGE TANK COMPONENTS**

DESIGN	SEPTIC TANK 1	SEPTIC TANK 2	PUMP CHAMBER	SEPARATION DISTANCES	SEPTIC TANK 1	SEPTIC TANK 2	PUMP CHAMBER
Capacity in Gallons	<u>1000</u>			Distance to Dwelling	<u>10 ft</u>		
Constructed of	<u>Concrete</u>			Distance to Water	<u>100 ft</u>		
Manufacturer	<u>Ritchie Concrete</u>			Distance to Property Line	<u>20 ft</u>		
4" inspection port, or riser to surface?	☒ Riser	☐ Riser	☐ Riser	Effluent Filter?	☐ Yes	☐ Yes	
	☐ Port	☐ Port	☐ Port		☒ No	☐ No	

ABSORPTION FIELD**Class I System**

Design Type: _____

Manufacturer: Infiltrator Quick 4's Square footage: Permitted 900 Installed 900Number of Lines: 3 Trench Width (in): 36Abs. field line lengths (ft): 44, 136, _____, _____, _____, _____, _____, _____Inspection ports installed? ☐ Yes ☒ NoDistribution Box Installed? ☒ Yes ☐ No Outlets Level? ☒ Yes ☐ No☐ Gravel system ☒ Chamber System ☐ Bed (Chambers) ☐ Bed (Gravel) ☐ Eljen ☐ Gravelless PipeDiameter (in): _____ TL Length (ft): 180 Unit Length (ft): 4 Width (in): 36 No. of units: 45Max depth (in): 30 Minimum Depth: 24 Average Depth: 21 (for bed, use uphill side)Drainfield Installed On Contour? ☒ Yes ☐ No**Class II System**

Design Type: _____

Remarks: _____

ON SITE SEWAGE DISPOSAL SYSTEM

FINAL INSPECTION REPORT

System is installed as per the permitted design and layout.

☐ Yes




No

SAME SQ FT, DIFFERENT LAYOUT

Sketch of Installation with Triangulation or Distance to Specific Landmarks (include reserve area boundaries)

LEGEND:

- | | | | | |
|-----------------------|-------------------------------|----------------------|-------|-------------|
| House/Facility | Property Line | X X X Fence | North | Pump Tank |
| Soil Absorption Line | Single Wide Manufactured Home | | | Septic Tank |
| Existing Water Supply | Distribution Box | Stream Flow | | |
| Proposed Water Supply | Drain Field Inspection Port | Wooded Area Boundary | | |

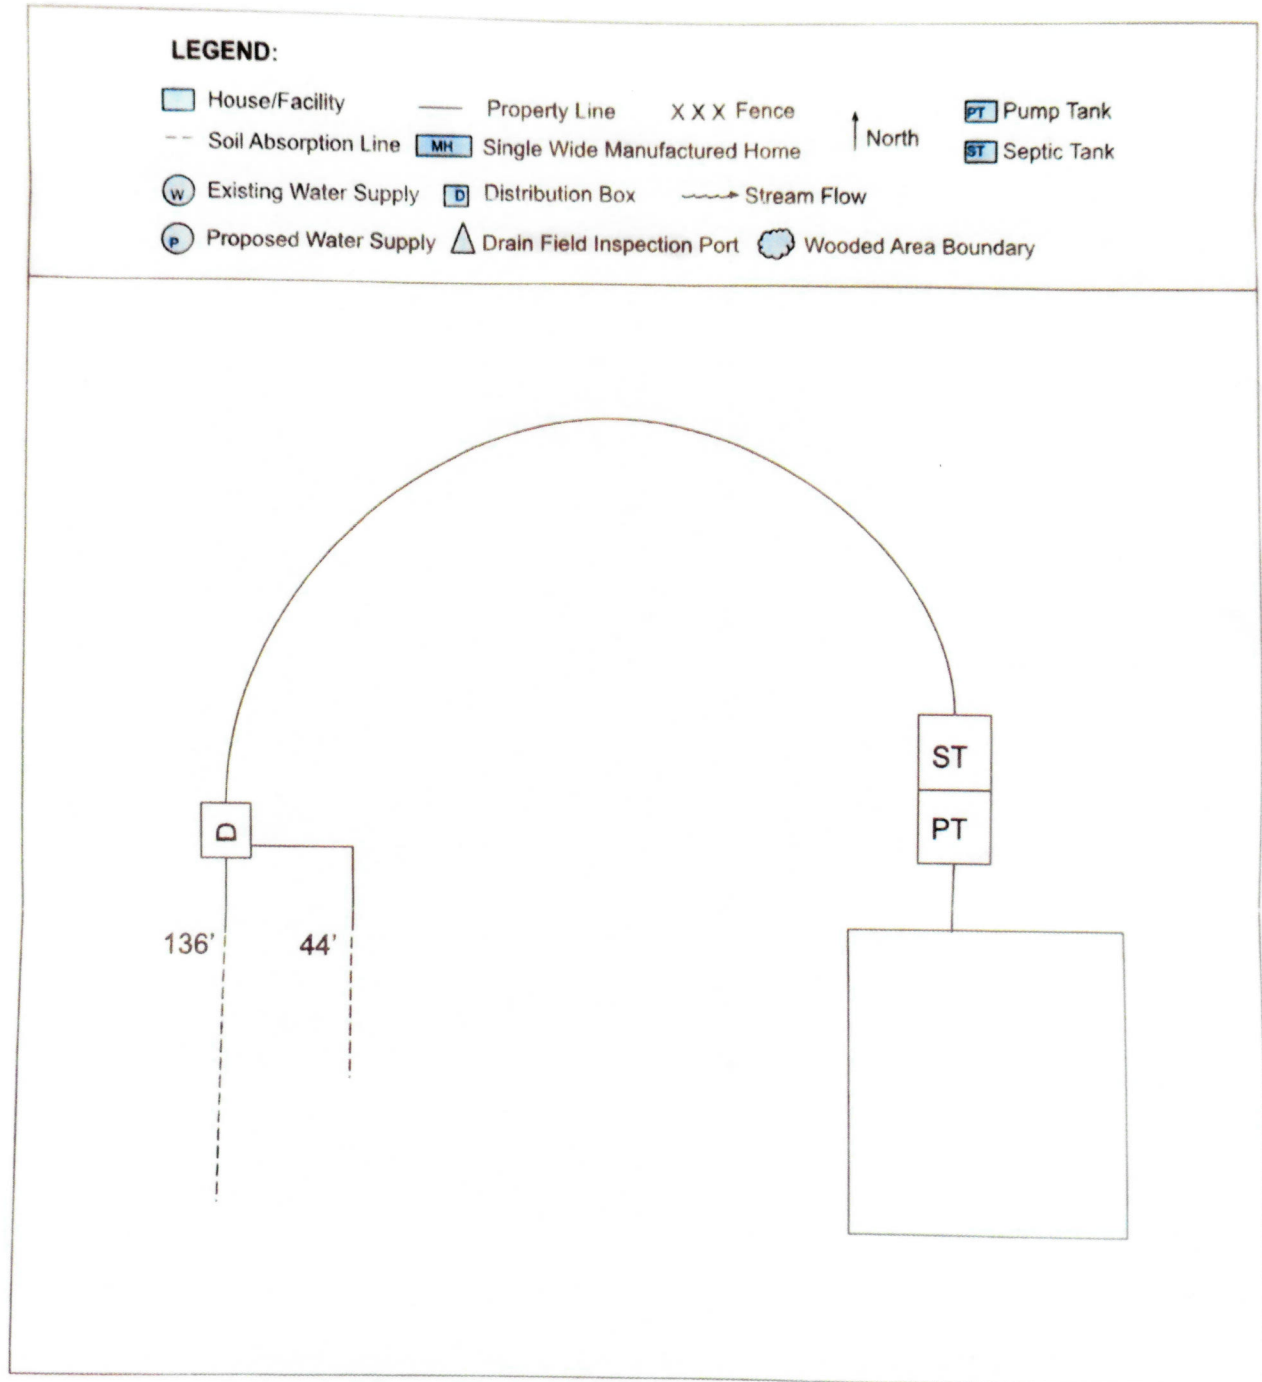

4/26/23
Dates visited:

8/23/23

James Shure, R.A.
Sanitarian