

APPLICATION ONLY

SEPTIC SYSTEM APPLICATION

FLATHEAD COUNTY SANITATION OFFICE

PERMIT NO. 89-65-829

ON-SITE RECEIPT

1. TR6D (CoS 6304) Co. 7/10.8/124 254 St. 8-29-22 2. 2.306 Ac.
Legal Description of Property W 752 - 1402 Tim Parcel Size
3. Paul Stobel 755-9774 4. Same
Legal Property Owner Property Occupant
5. 1803 Church Dr., Kal. Same
Address & Phone Property Address
6. Proposed Dwelling: Conv. Sing. Fam. _____; Mob. Home _____; Multi-fam. (specify) _____; Other _____
7. No. of Bedrooms: 3 Existing Structures: Trailer Water: well existing ~80'
8. Septic System: New _____ Remodel X Installer: Orville Kraft or Baker

I HEREBY DECLARE the above information is true, complete and correct to the best of my knowledge. I will install the system according to the FLATHEAD COUNTY REGULATIONS FOR SEWAGE TREATMENT SYSTEMS and the terms of the permit. I acknowledge that the County has not designed my system and that these requirements do not bind or obligate the County to guarantee this system's operation. I FURTHER AGREE to call and give 24 hours ADVANCE NOTICE for REQUIRED INSPECTIONS of the SYSTEM. PLEASE PHONE 752-5300 Ext. 350.

Date 4-25-89 Signature of Applicant Paul T. Stobel

1. Septic Tank Size: Existing 900 gallons (min.)

2. Soil Type & How Determined: _____

Stoney loam
Prew. exp.

3. Depth of Water Table/Bedrock & How Determined: _____

>7ft - Prew. exp.

4. Absorption Area: 540 ft²

5. Describe Drainfield: Trenches must be no deeper than 3 ft.

Use 270 linear ft. of 2 ft. wide trench using
multiple lines no longer than 80 ft.

Be sure of 100 ft. setback from well

Site Evaluator's Comments

Best replacement site
just north of existing
drainfield.


Ⓢ A D-box or other diversion device can be installed
just at outlet of tank which would permit
re-use of existing drainfield in the future.

Date 4/27/89 Signature Authorizing Approval of Permit Application Allen Gray R.S.

*These requirements establish the MINIMUM SIZE FOR THIS SEPTIC SYSTEM INSTALLATION. Permit will be voided and declared invalid if the system is not installed within 12 months of the issuance of this permit.

Please phone 752-5300 Ext. 350 for inspection when system is completely installed except for backfill. Please notify this office at least one day in advance for prompt service.

LAYOUT

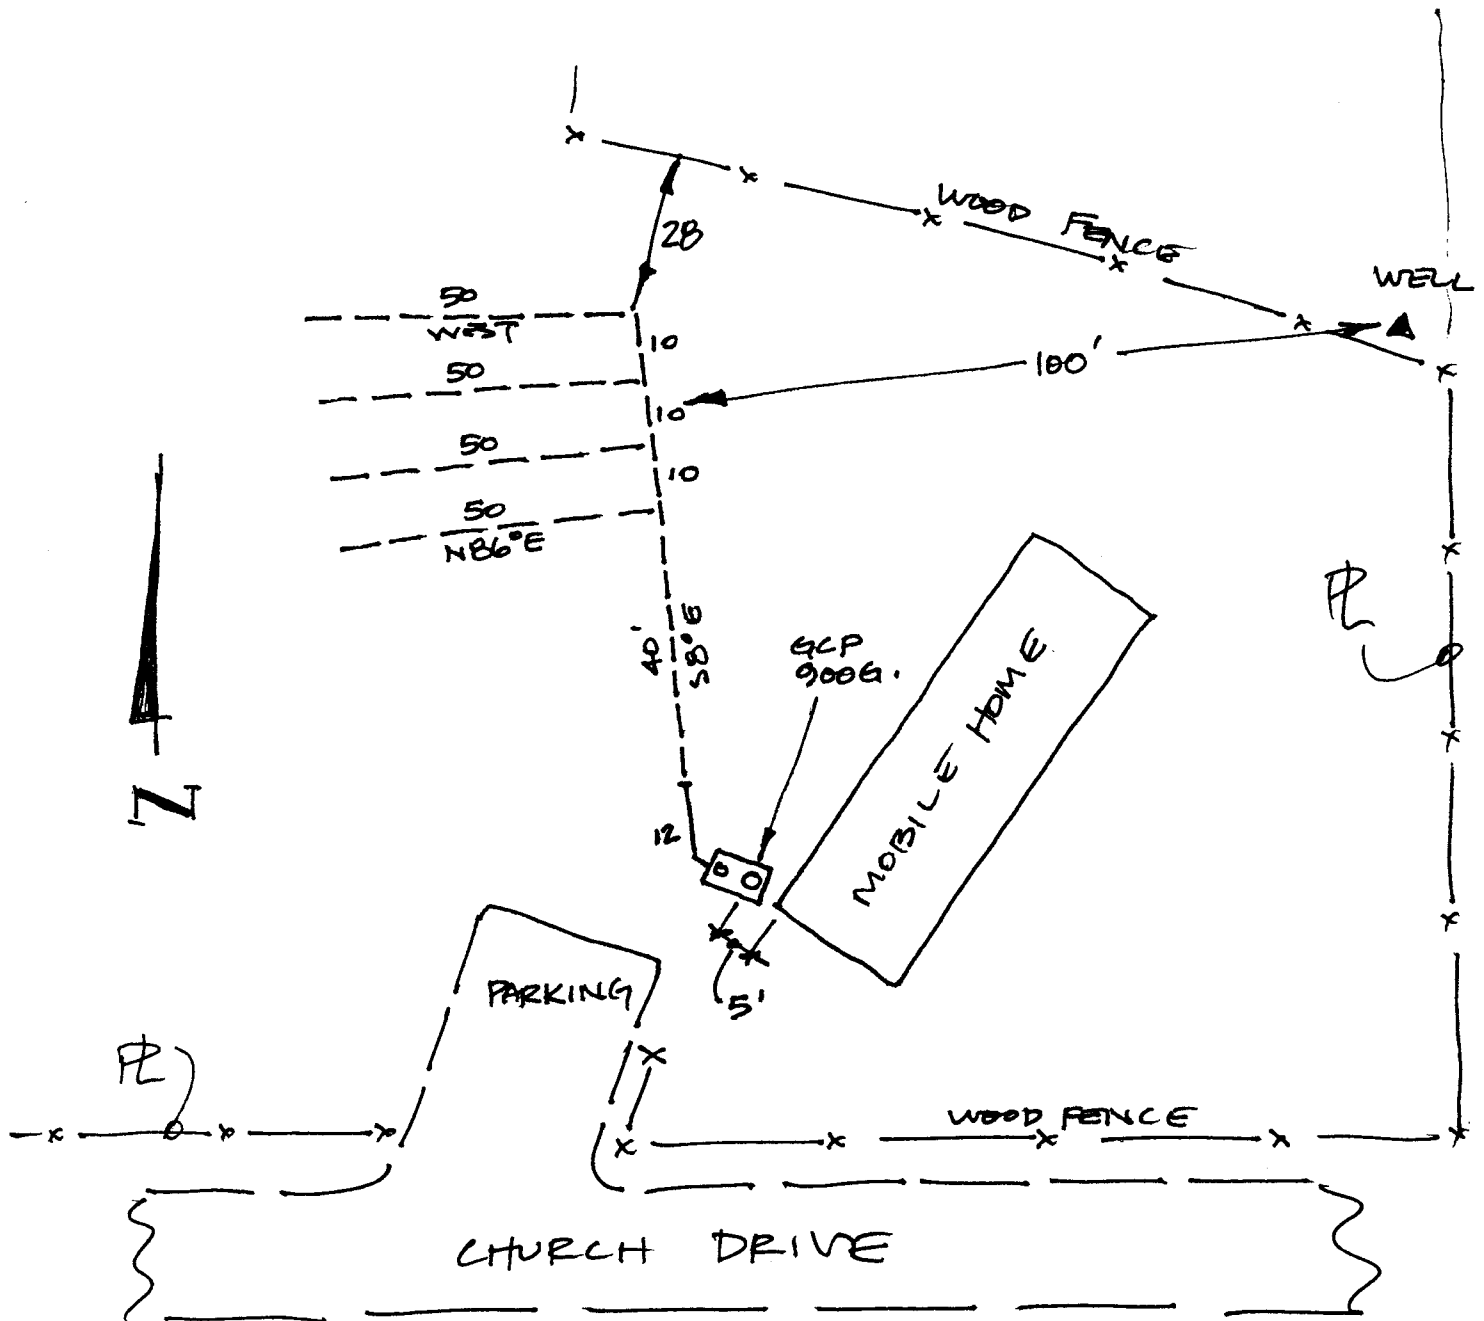

Date 5/1/89 Inspected By Drew Paslawsky

Approved ☒ Disapproved* ☐

Inspector Comments OLD DRAINFIELD BUILT W/ ORANGEBURG PIPE
(ASPHALT & PAPER), SO NO D-BOX INSTALLED.

Name of Installer: BATTEE