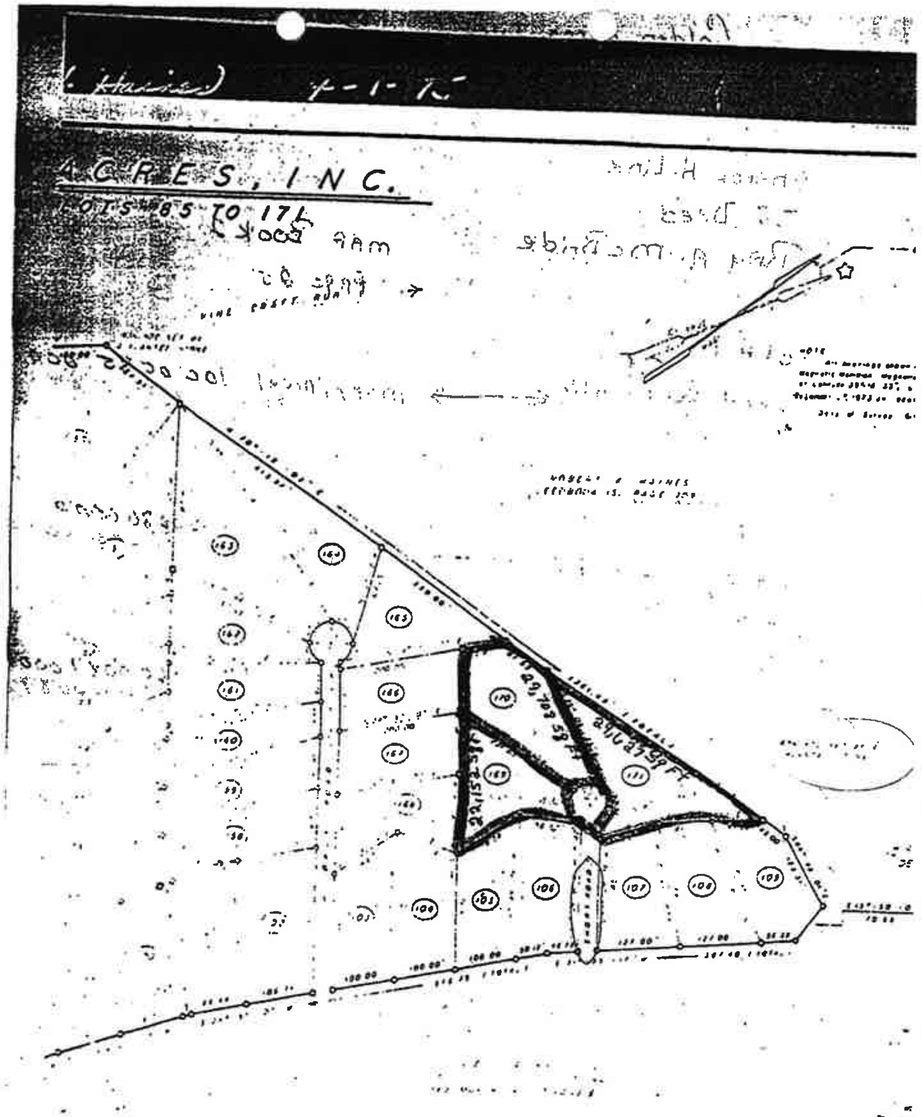
ACRES, INC.
LOTS 85 TO 171
ROBERT E. HAINES

Lot #171

pec 12-4-02

WV STATE DEPARTMENT OF HEALTH
Office of Environmental Health Services
ENVIRONMENTAL ENGINEERING DIVISION

WELL COMPLETION REPORT

Date(s) 11-22-02 County Hampshire Permit #: DW-14-03-73

Town: Augusta Area Name/Location AA Rodgers Rd., Right on Ridge View Rd.

Well Owner: M & W Associates Address: HC 71 Box 44
Augusta, WV 26704

Telephone Number:

Well Driller: Christopher Wolford Address: P. O. Box 952
romney, WV 26757

Telephone Number: 822-4092

WELL LOG

DEPTH IN FEET	FORMATIONS: KIND, THICKNESS, AND IF WATER BEARING
0-2	Sft. Dirt, Loose Rocks
2-20	Brown Sandstone
20-28	Lt. Brown Shale
28-80	Gray Shale
80-94	Red Shale
94-120	Gray Shale
20-190	Gray Sandstone
190-200	Red Sandstone
200-220	Gray Sandstone

REMARKS: Pressure Grouted

Type of Well: D/W Drilling Method: Air Percussion

Well Diameter: 6 1/4" Casing O.D.: 6 5/8"

Well Depth: 220 Date Completed: 11-21-02

CASING: Length 40 Feet Height above ground 1 Feet

☒ Steel ☐ Plastic ☐ Cast Iron

Other _____ Type

SCREEN

☒ None Installed

Type _____ Diameter _____

Slot/Gauge _____ Length _____

Set Between _____ Ft. and _____ Ft

PUMPING OR BAILING TEST

DETAILS	#1	#2	#3
Static Water Level (Ft. Below Grade)	40		
Pumping Rate (GPM)	75		
Pumping Level (Ft Below Grade)	218		
Duration of Test (In Hours)	2		
Recovery Time to Static Level (In Hours)	1		

WELL HEAD

Pitless Adapter: Type, Make, Etc. _____

Well Cap: Type, Make, Etc. _____

Well Seal: Type, Make, Etc. _____

Well Platform:

Length _____ Width _____ Thickness _____

Grouting: ☒ Yes ☐ No Pressure
All Public Water Supplies must be grouted.

I hereby certify that this well was drilled and constructed under my supervision, in compliance with all requirements of the referenced permit, and that this reco is true to the best of my knowledge and belief.

christopher Wolford 574
Name Certification No.

Miller Bros. Drilling
Registered Business Name

Christ Wolford 11-22-02
Signed Date

7/98
...TION TO BE
...TED OR TYPED

Lot# 170

STATE OF WEST VIRGINIA
HAMPSHIRE Co HEALTH DEPARTMENT
ON-SITE SEWAGE DISPOSAL SYSTEM INSPECTION FORM

Permit No.: ST-14-03-63
Tax Map: _____ Parcel #: _____
County Road: _____

County: HAMPSHIRE

Name of Owner: RAY McBRIDE Installer: GARY CARPENTER
Address: HC 71 Box 44 AUGUSTA WV 26704
Property Location: GOLDEN ACRES; RIDGE VIEW RD .4m on (L)
Type of Facility: RESIDENCE Facility is: New (X) Existing ( ) Lot Size: 29708 Sq. Ft./Acres
Design Loading in gpd/No. Bedrooms: 3 Source of Water Supply: WELL

SEWAGE TANK COMPONENT

Capacity in Gallons: 1000 Material: CONCRETE Manufacturer: JOLIN
Distances (in feet) of Tank to: Dwelling: N/A Private (X)/Public ( ) Water Source: 50' Property Line: 10'

ON-SITE DISPOSAL SYSTEM

Class I Systems: Standard Soil Absorption Trenches ( ) or Bed ( ) Gravelless Pipe ( ), Diameter: ____ Inches
Chamber Soil Absorption Trenches (X) or Bed ( )
Class II Systems: Pumped/Dosed Soil Absorption Trenches ( ) or Bed ( ) Evapotranspiration Trenches ( ) or Bed ( )
Shallow Soil Absorption Trenches ( ) or Bed ( ) Other: _____

No. of Lines: 4 Length (in feet) of Each: 60, 60, 60, 60, ____, ____, ____
Width of Trenches: 36 inches/feet Depth to Bottom of Field: 36 inches
If Bed, Dimensions (in Feet): _____ If Chamber System, Name: _____, No. of Units: 40
Approved and Adequate Materials Used? Yes ( ) No ( ) Size Equates to: 1200 Square Feet of Standard Gravel Field.
Distances (in feet) of System to: Dwelling: N/A Private (X)/Public ( ) Water Source: 100' Property Line: 10'+
Remarks: NO HOME YET

An inspection indicates that the sewage disposal system described above
DOES MEET (X),
DOES NOT MEET ( ),
CANNOT BE DETERMINED TO MEET ( ) the minimum standards established by the West Virginia Bureau of Public Health.

To correct a health hazard, modifications to existing systems may be done to improve part of a system. Such modifications may not be able to be designated as a **does meet** system since inadequate information is known.

Although many factors contribute to the successful functioning of a sewage disposal system, this office recommends water conservation and maintaining an even usage of water throughout the week.

Sketch of Installation with Triangulation or Distance to Specific Landmarks:

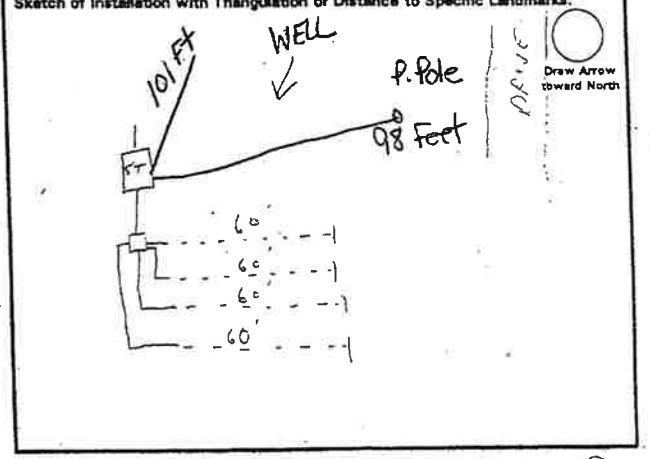

Visit Date(s): 9/3/02