

INFORMATION ABOUT ON-SITE SEWER FACILITY

USE OF THIS FORM BY PERSONS WHO ARE NOT MEMBERS OF THE TEXAS ASSOCIATION OF REALTORS®, INC. IS NOT AUTHORIZED. ©Texas Association of REALTORS®, Inc., 2004

CC		Clyde Accord Rd. klin, TX. 77856				
A. DESCRIPTION OF ON-SITE SEWER FACILITY ON PROPERTY:						
	(1) Type of Treatment System: X Septic Tank Aerobic Treatment		Unknown			
	(2) Type of Distribution System: Field Lines.		Unknown			
	(3) Approximate Location of Drain Field or Distribution System: See		Unknown			
	(4) Installer:		X Unknown			
	(5) Approximate Age: 1986		Unknown			
В.	MAINTENANCE INFORMATION:					
	(1) Is Seller aware of any maintenance contract in effect for the on- If yes, name of maintenance contractor:	,	Yes X No			
If yes, name of maintenance contractor: Phone: contract expiration date: Maintenance contracts must be in effect to operate aerobic treatment and certain non-standard" of sewer facilities.)						
	(2) Approximate date any tanks were last pumped?					
	(3) Is Seller aware of any defect or malfunction in the on-site sewer facility? If yes, explain:		Yes X No			
	(4) Does Seller have manufacturer or warranty information availab	le for review?	Yes X No			
C.	. PLANNING MATERIALS, PERMITS, AND CONTRACTS:					
	(1) The following items concerning the on-site sewer facility are attached: planning materials permit for original installation final inspection when OSSF was installed maintenance contract manufacturer information warranty information Approximate location of septic tank and field lines attached.					
	(2) "Planning materials" are the supporting materials that describe the on-site sewer facility that as submitted to the permitting authority in order to obtain a permit to install the on-site sewer facility.					
	(3) It may be necessary for a buyer to have the permit to operate an on-site sewer facility transferred to the buyer.					
(T)		nd Seller , , , , , , , , , , , , , , , , , , ,	Page 1 of 2			

J. Fleming Lot 367

D. INFORMATION FROM GOVERNMENTAL AGENCIES: Pamphlets describing on-site sewer facilities are available from the Texas Agricultural Extension Service. Information in the following table was obtained from Texas Commission on Environmental Quality (TCEQ) on 10/24/2002. The table estimates daily wastewater usage rates. Actual water usage data or other methods for calculating may be used if accurate and acceptable to TCEQ.


<u>Facility</u>	Usage (gal/day) without water- saving devices	Usage (gal/day) with water- saving devices
Single family dwelling (1-2 bedrooms; less than 1,500 sf)	225	180
Single family dwelling (3 bedrooms; less than 2,500 sf)	300	240
Single family dwelling (4 bedrooms; less than 3,500 sf)	375	300
Single family dwelling (5 bedrooms; less than 4,500 sf)	450	360
Single family dwelling (6 bedrooms; less than 5,500 sf)	525	420
Mobile home, condo, or townhouse (1-2 bedroom)	225	180
Mobile home, condo, or townhouse (each add'l bedroom)	75	60

This document is not a substitute for any inspections or warranties. This document was completed to the best of Seller's knowledge and belief on the date signed. Seller and real estate agents are not experts about on-site sewer facilities. Buyer is encouraged to have the on-site sewer facility inspected by an inspector of Buyer's choice.

Signature of Seller Jennifer Fleming (Executor)	Date	Signature of Seller of Jh. Mac Mareth Estate (Deceased)	Estate Date of Mac Me
Receipt acknowledged by:		1	Deceased 11-8
Signature of Buyer	Date	Signature of Buyer	Date

(TXR-1407) 1-7-04

Septic Diagram

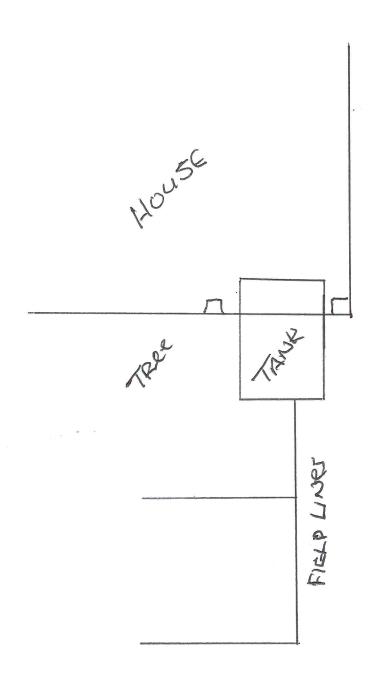

LAKE